


Gidw.

PROJECT Phase II SHEET _____ OF _____
SUBJECT _____ DATE 7-17-18
JOB NO. 4447
BY Atlas

226 E State

↑
N

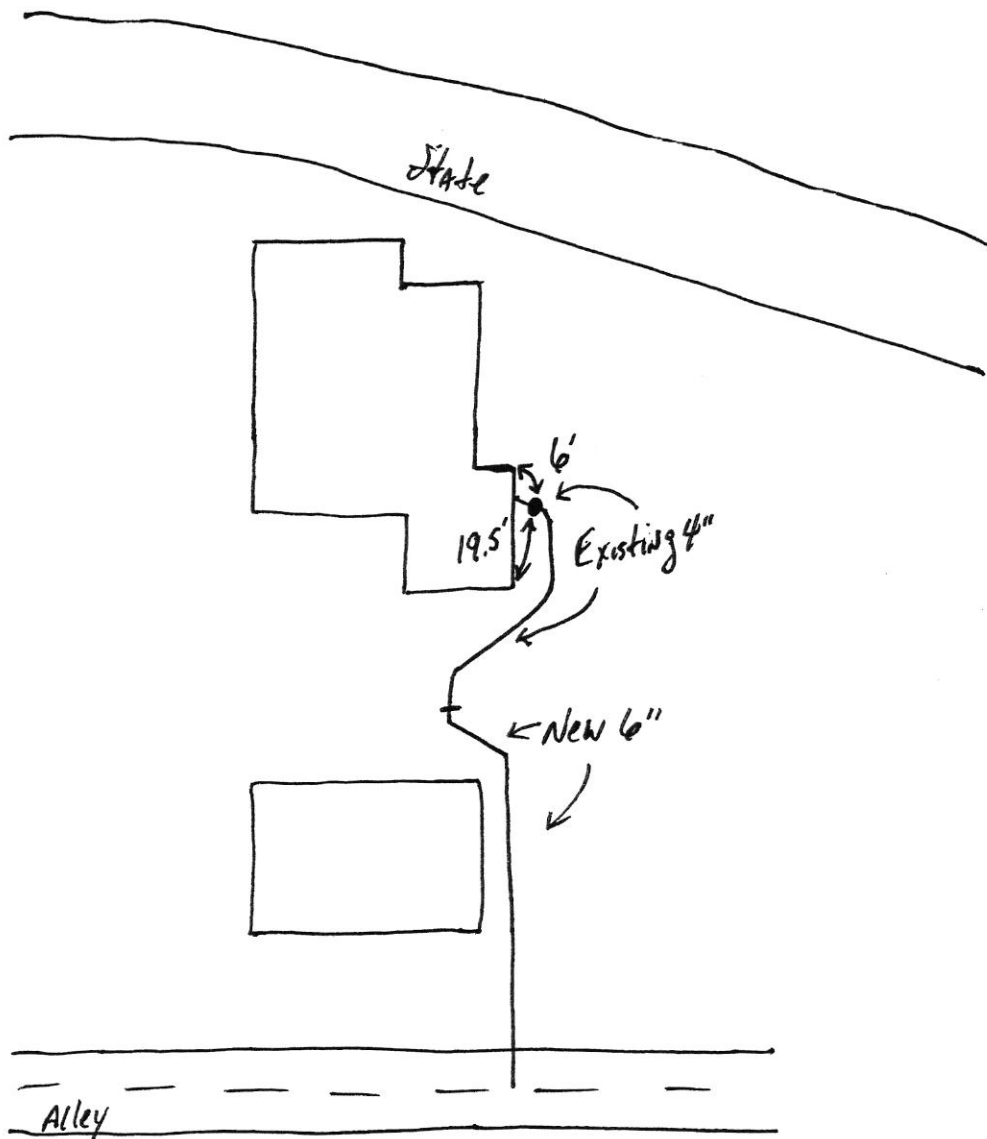

2010 E State

SF Phase II

7.30.18

