


Side

PROJECT Phase II SHEET _____ OF _____
SUBJECT _____ DATE 1-15-19
JOB NO 4447
BY Atlas

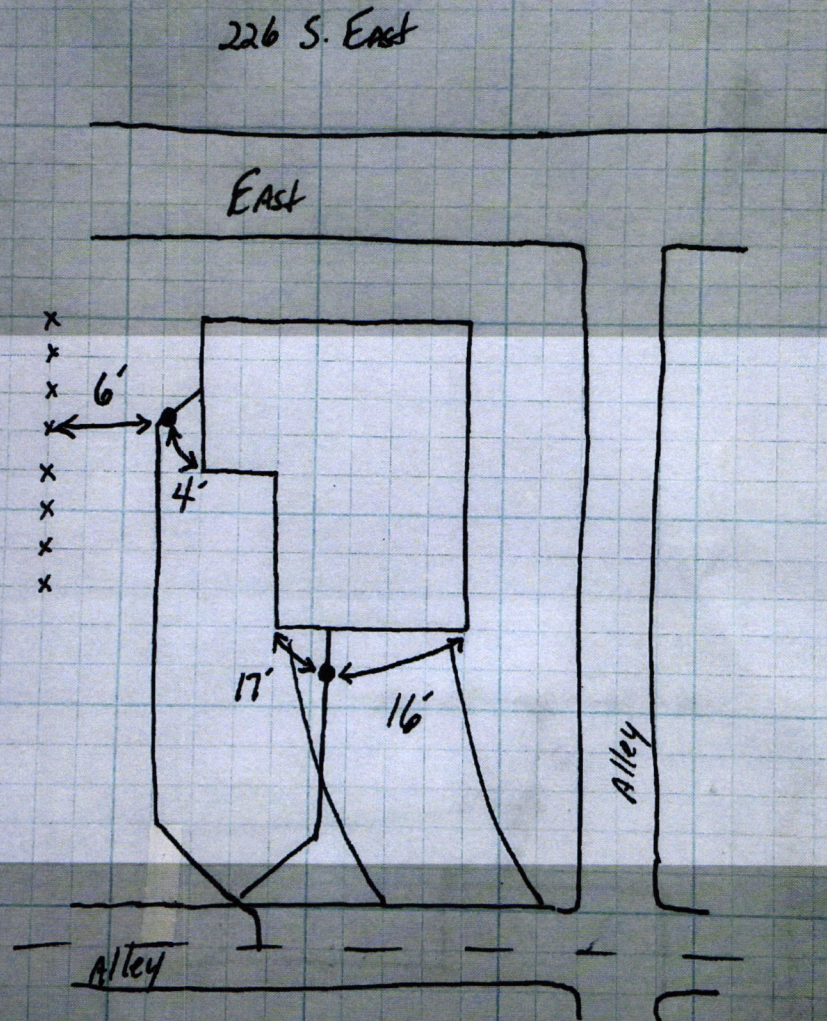

2260 S Post St

SRF Phase II

1-15-19



Gidw.

PROJECT PHASE II

SHEET _____ OF _____


SUBJECT _____

DATE 7-3-18

JOB NO. 4447

BY ATLAS


226 S. EAST ST.

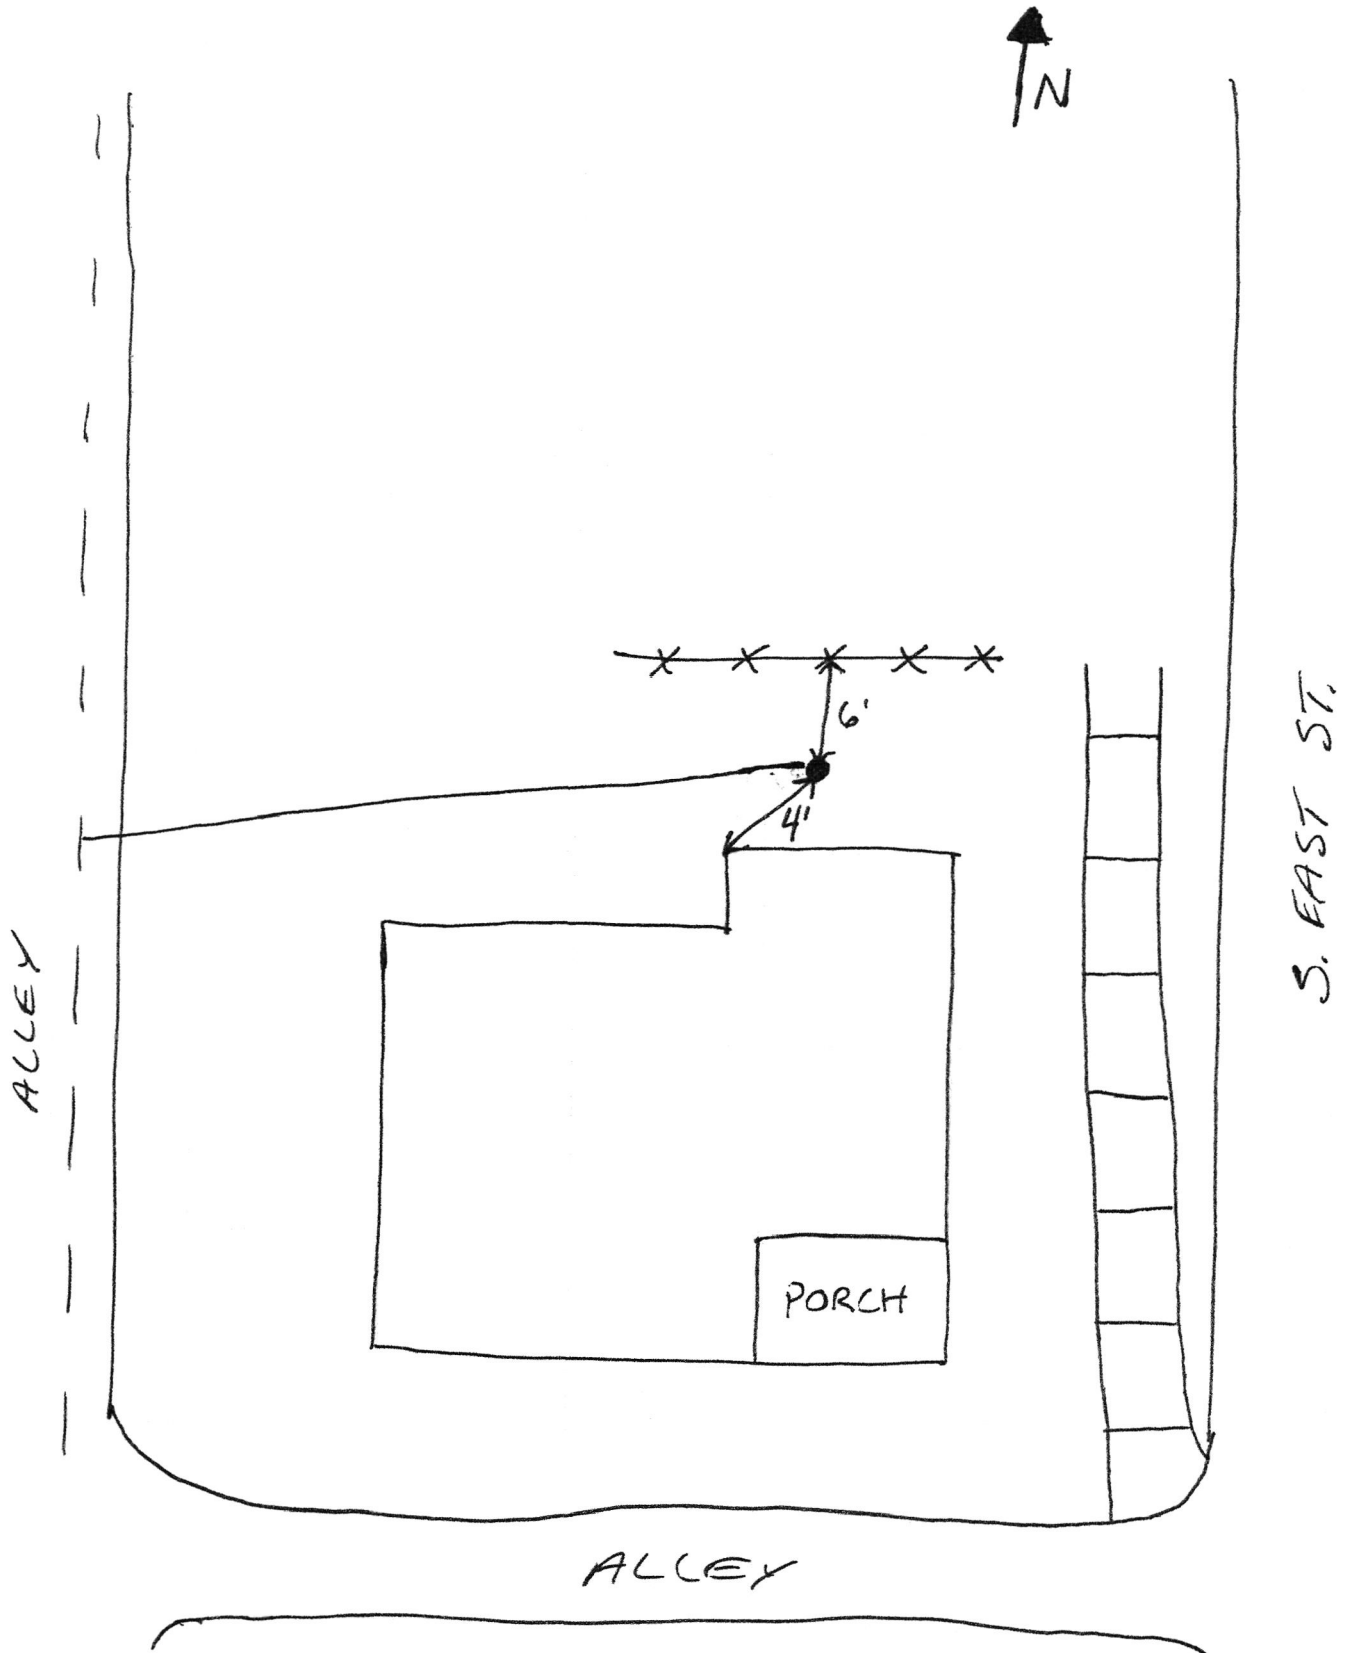

206 East

SF Phase II

7.6.18

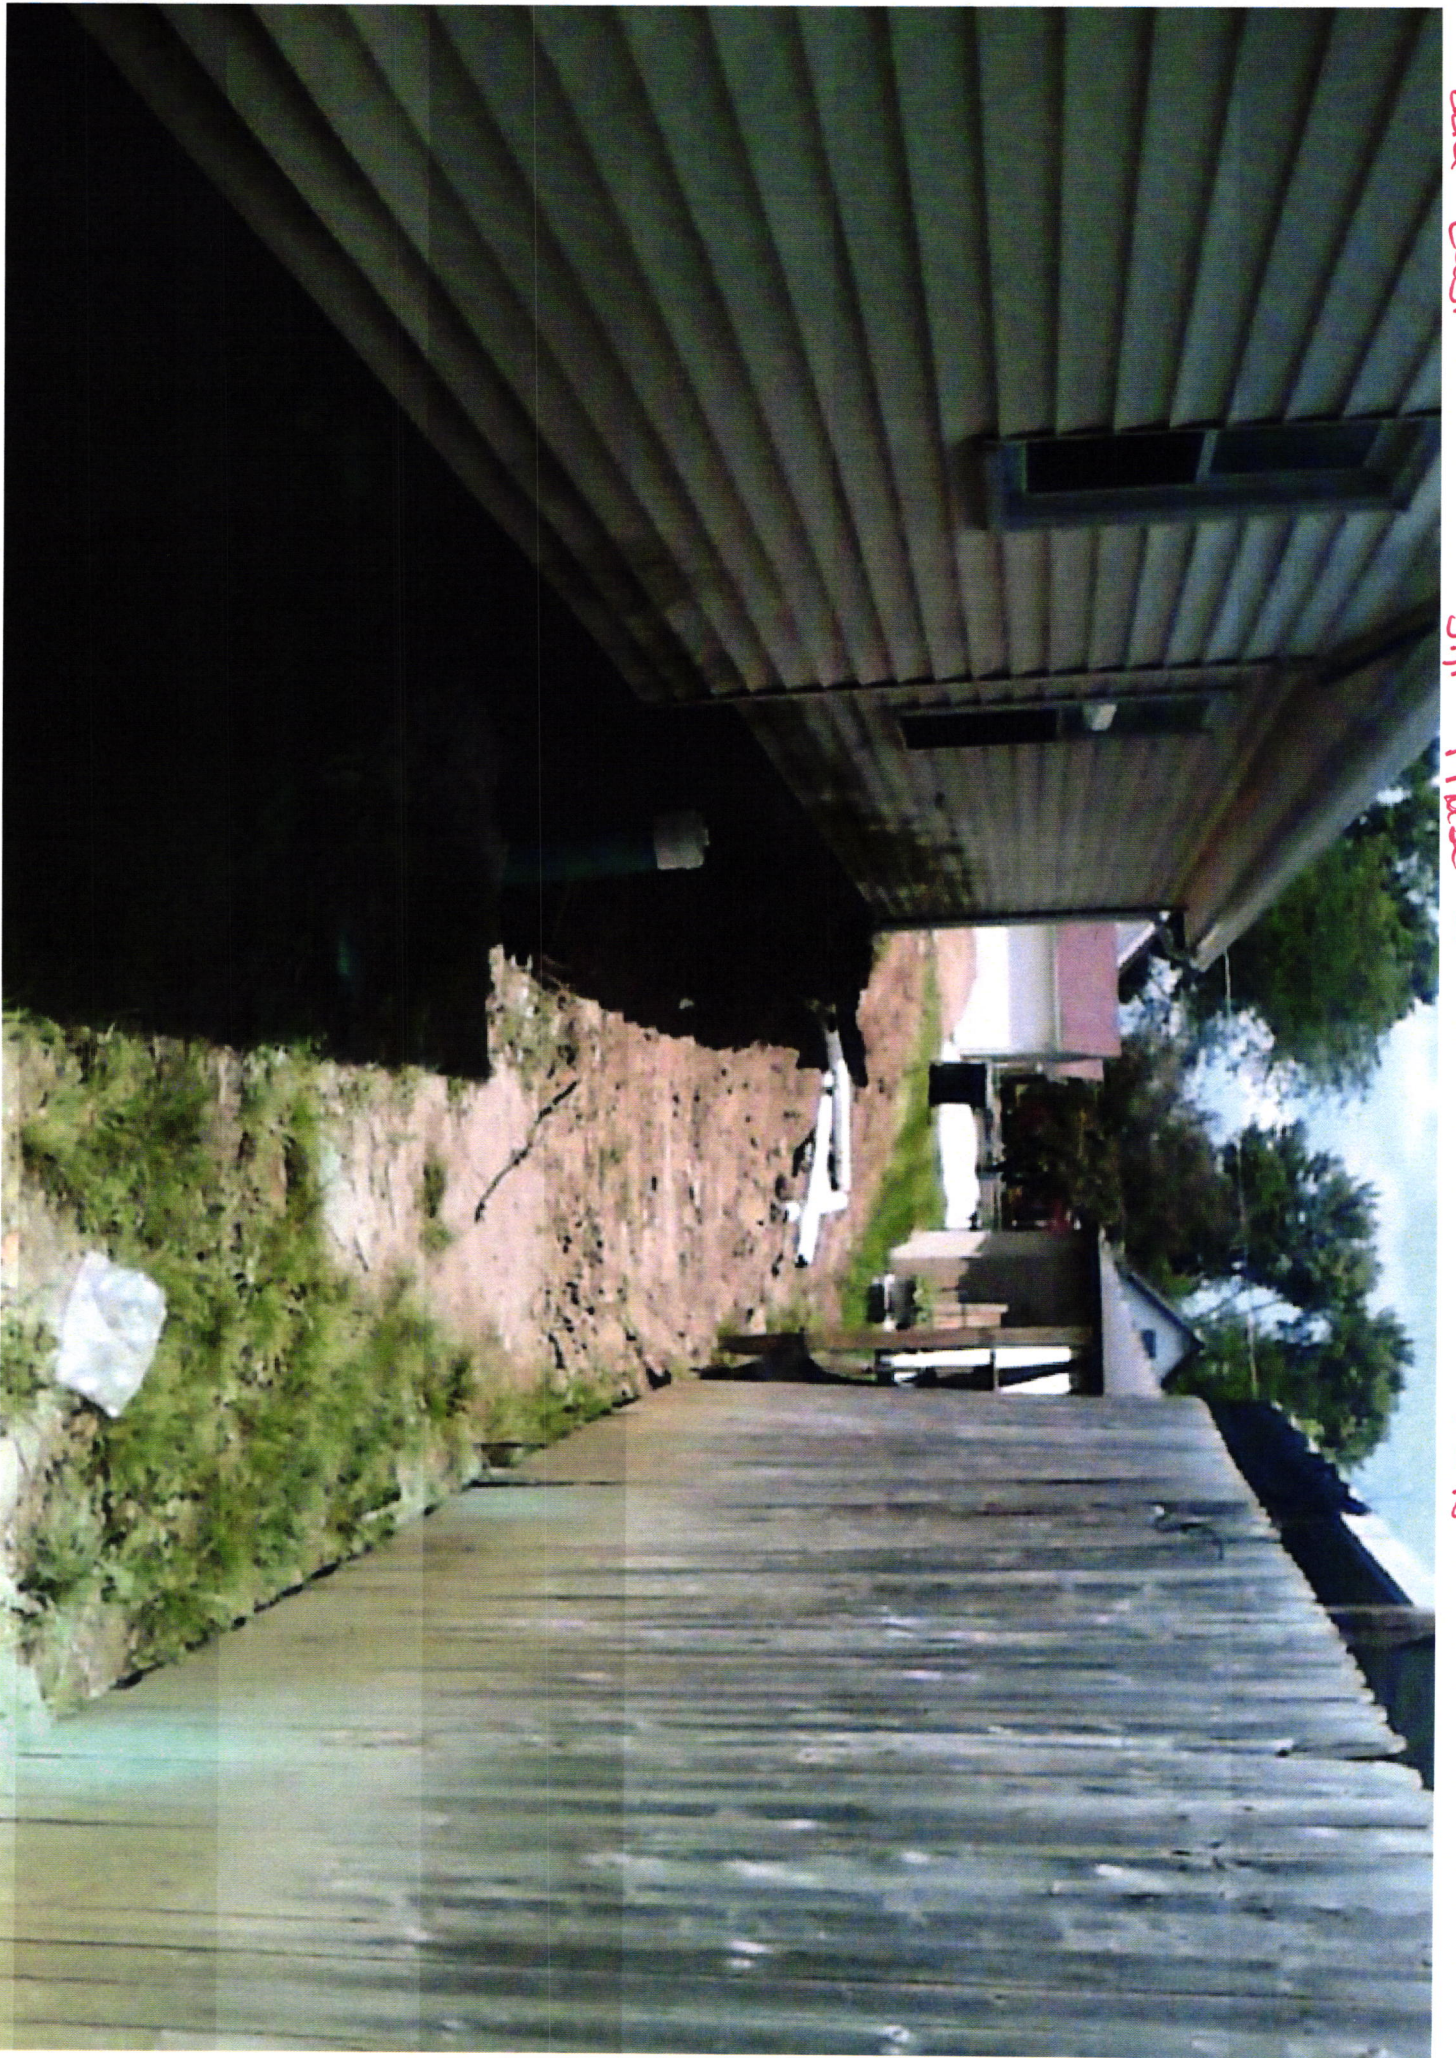

2246 S East St

SRF Phase II

Tim McCurdy 2/19/19



220 S East ST

SRP Phase II

Tim McClurey 2-19-19



226 S East St

SRF Phase II

Tim McLurdy

2/19/19



226 S East St

Stf Phase II

Tim McClurey 2-19-19

