

Gidw.


PROJECT Phase II SHEET _____ OF _____

SUBJECT _____ DATE 3-21-18

JOB NO. 4447

BY Atlas

226 Franklin

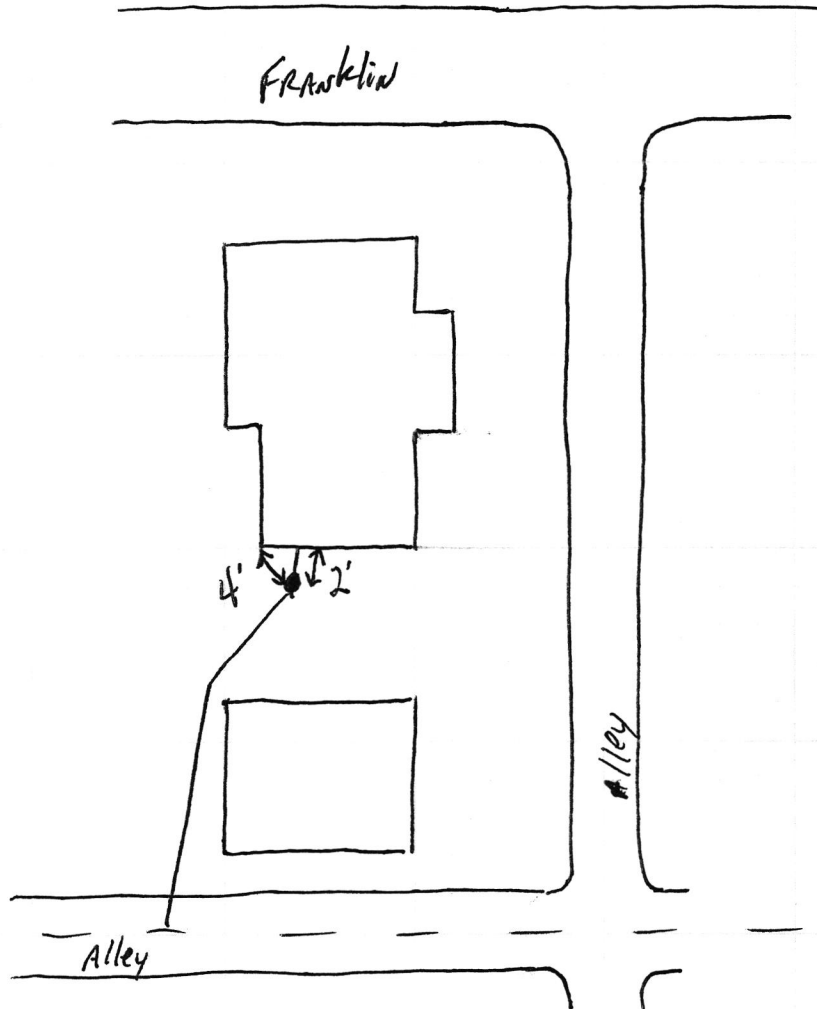

2260 Franklin

SRF Phase II

