


Gidw.

PROJECT Phase II SHEET _____ OF _____
SUBJECT _____ DATE 4-11-18
JOB NO. 4447
BY Atlas

226 S. Jefferson

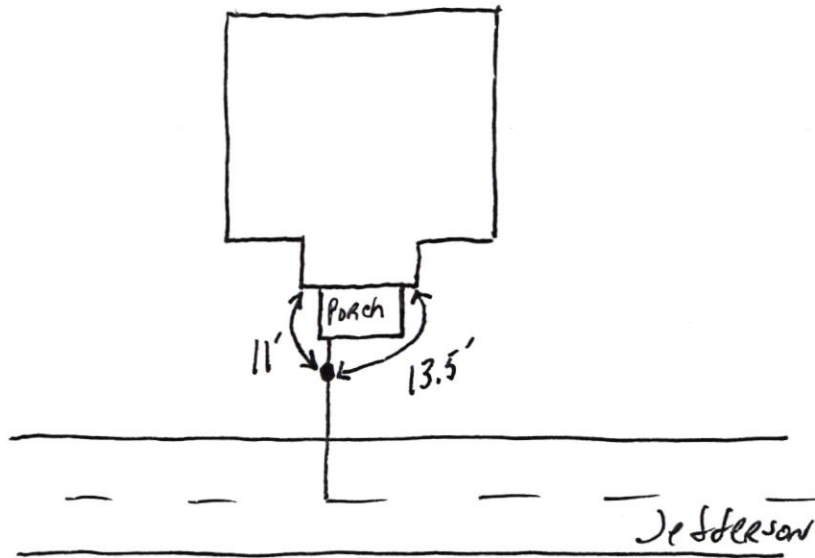

2216 S Jefferson

SRP
Phase II

4.20.18

