

Gidw.

PROJECT Phase II

SHEET _____ OF _____

SUBJECT _____


DATE 3-19-18

JOB NO. 4447

BY Atlas

226 S. Adams

Adams

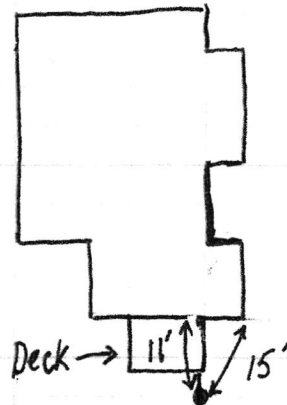

Alley

226 S Adams

SRP Phase II

