


Gidw.

PROJECT Phase II SHEET _____ OF _____

SUBJECT _____ DATE 2-5-18

JOB NO. 4447

BY Atlas

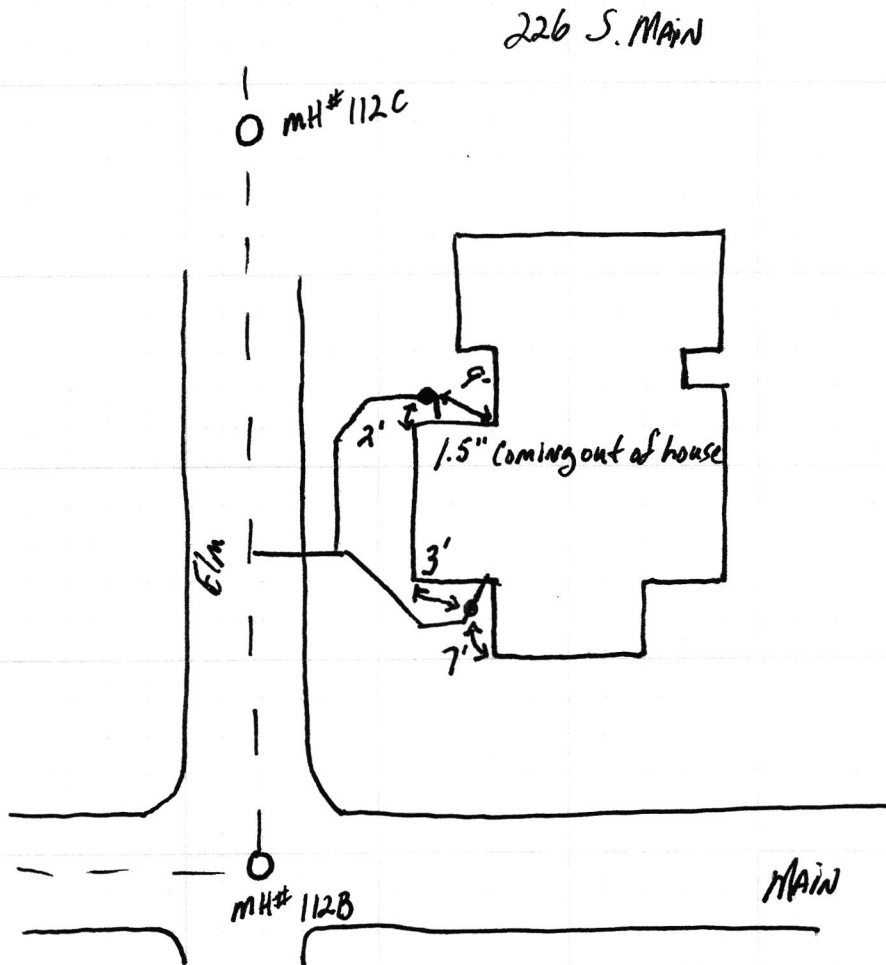

226 S main

SRF Phase II



226 S main

SPP Phase II

