


26-01868.00

765-778-7544

This Agreement made and entered into this 25th day of April, 2001, between FALL CREEK REGIONAL WASTE DISTRICT ("District") and Jay Brown ("Applicant") regarding the provision of sanitary sewer service, and the assignment of capacity in, and connection to, the District's facilities for the premises located at 2277 W SR 38

NEW CONSTRUCTION

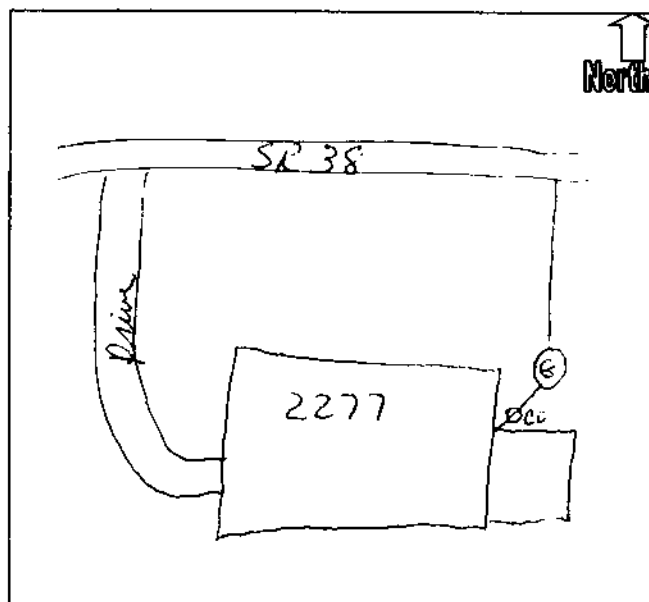



JOHN R. BROWN
JUDITH D. BROWN
2277 W ST RD 38 PH 178-T259
PENDLETON, IN 46084

14915

4/25/01

DATE

71-553/749
BRANCH 0

PAY TO
THE ORDER OF

F. C. R. W. S.

\$ 3033.80

Three Thousand Thirty-Three Dollars and 80/100

DOLLARS



© HARLAND METROPOLITAN



Madison
Community Bank

FOR

⑆074905539⑆

[Signature]

14915