

Gidw.


PROJECT Phase II SHEET _____ OF _____

SUBJECT _____ DATE 3-26-18

JOB NO. 4447

BY Atlas

227 Franklin

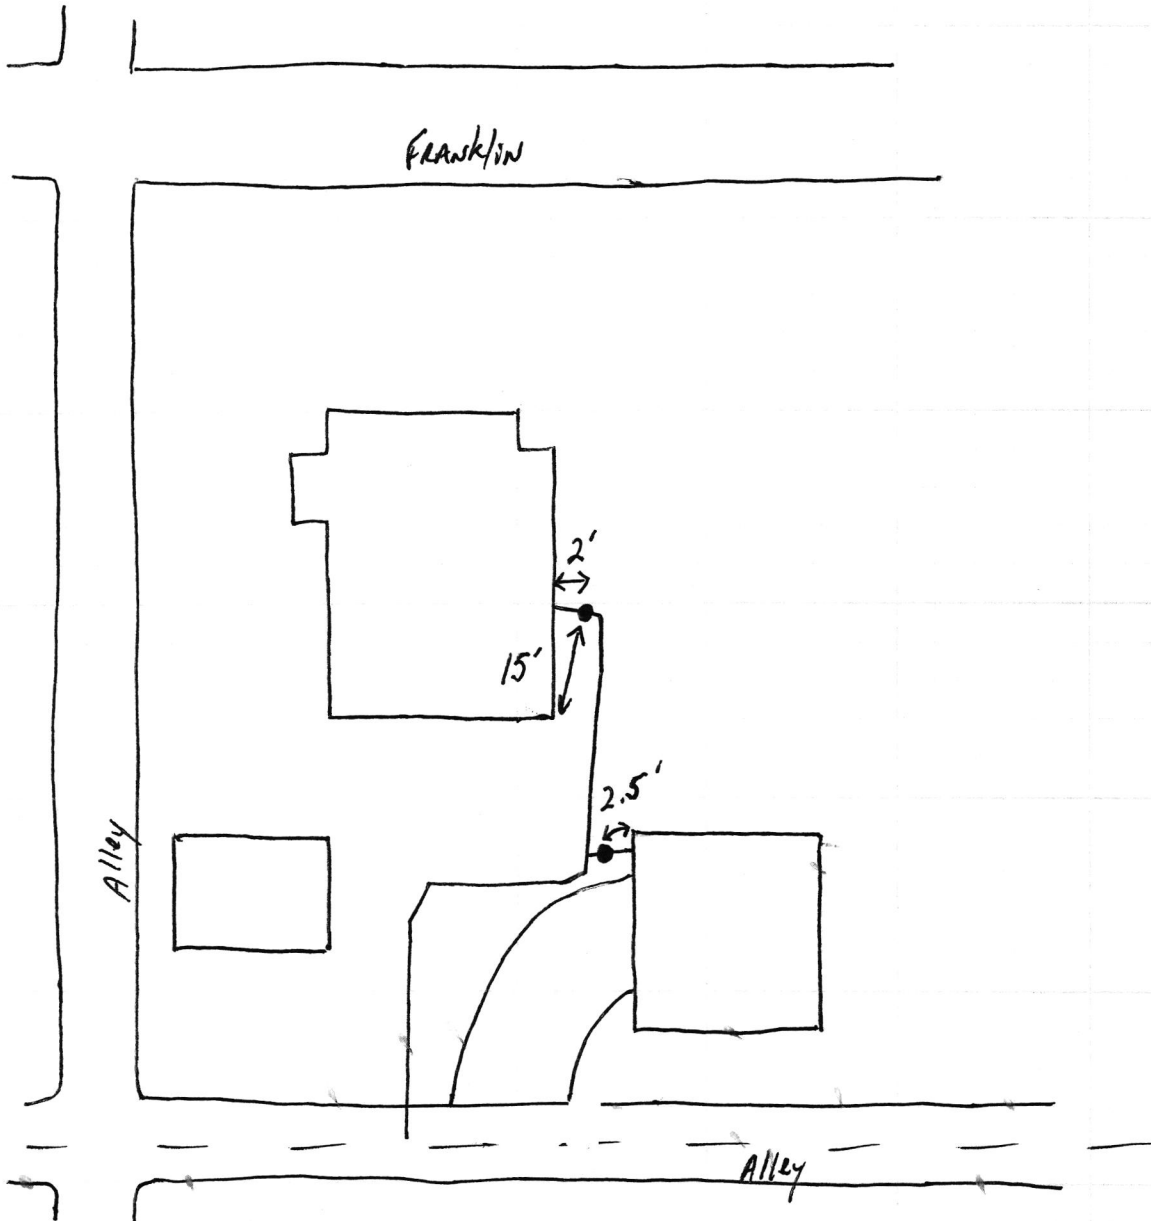

227 Franklin

SRF Phase II

