

Gidw.


PROJECT Phase II SHEET _____ OF _____

SUBJECT _____ DATE 4-5-18

JOB NO. 4447

BY Atlas

227 S. Jefferson

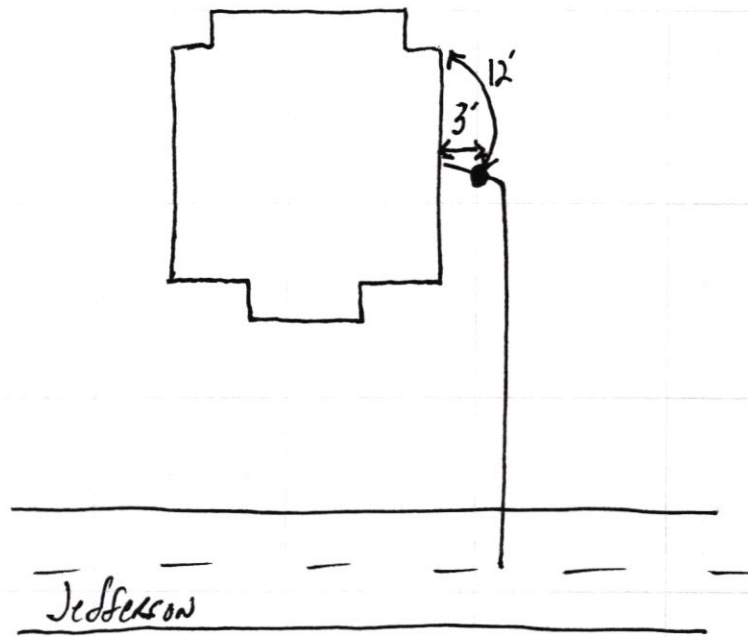

227 S Jefferson

SRF
Phase II

4.11.18

