

Gidw.

PROJECT

Phase II

SHEET

OF

SUBJECT

DATE

7-5-18

JOB NO.


4447

BY

Atlas

227 S. Pearl

N →

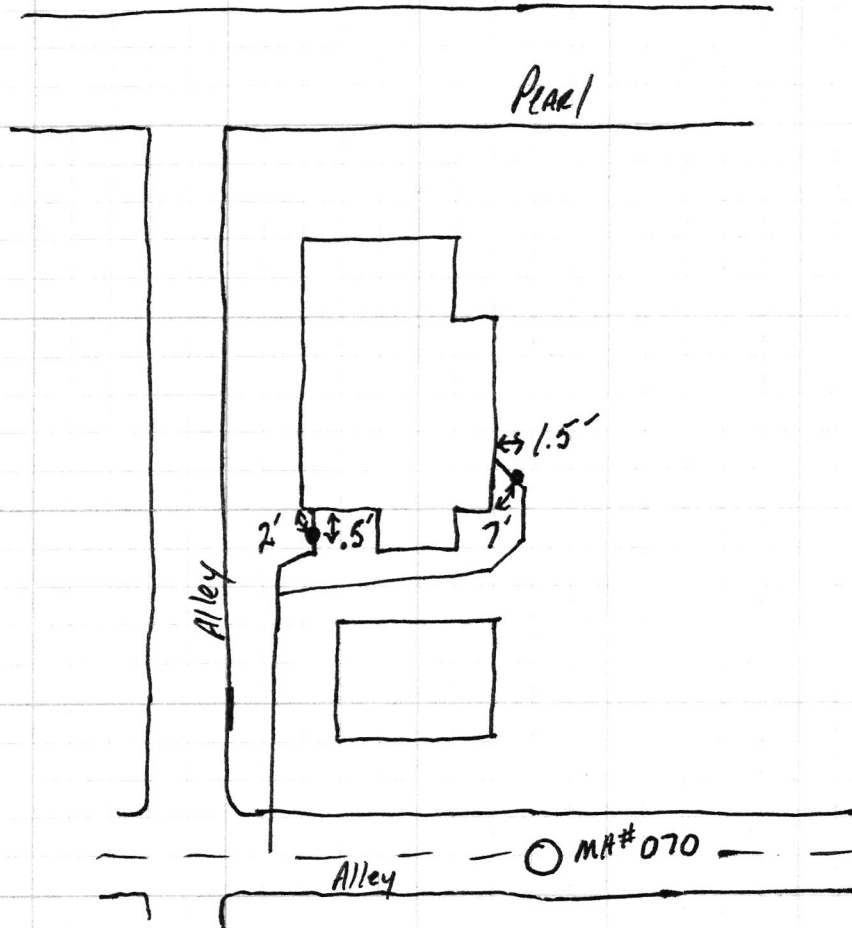

ad1 Pearl

SPT Phase II

7.6.18





my first

7.11.18