


Gidw.

PROJECT Phase II SHEET _____ OF _____
SUBJECT _____ DATE 3-20-18
JOB NO. 4447
BY Atlas

227 S. Adams

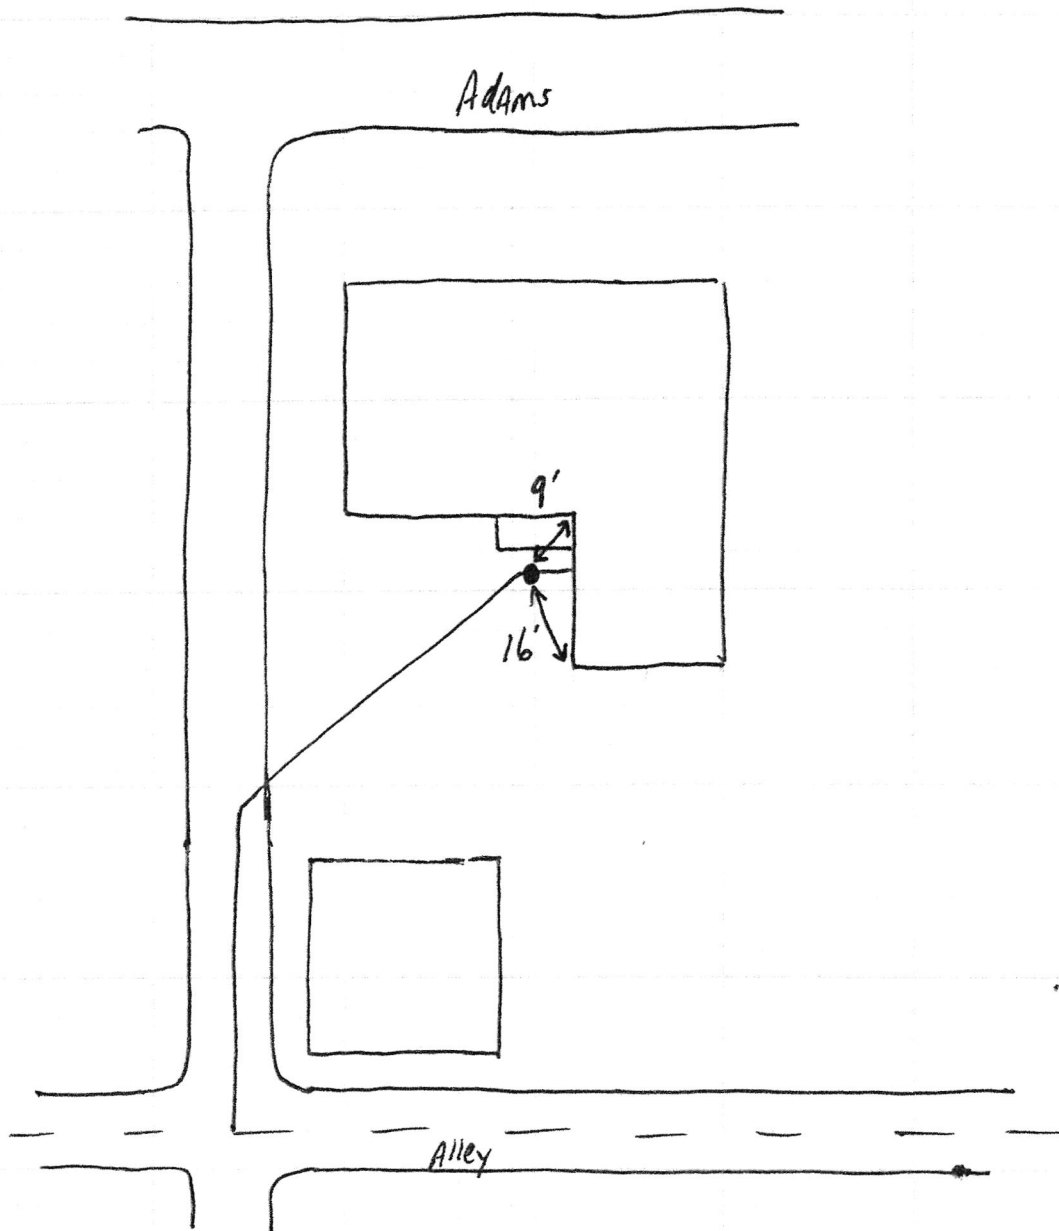

887 S Adams

SRF Phase II

