




PROJECT Phase II SHEET _____ OF _____

SUBJECT _____ DATE 2-20-18

JOB NO. 4447

BY Atlas

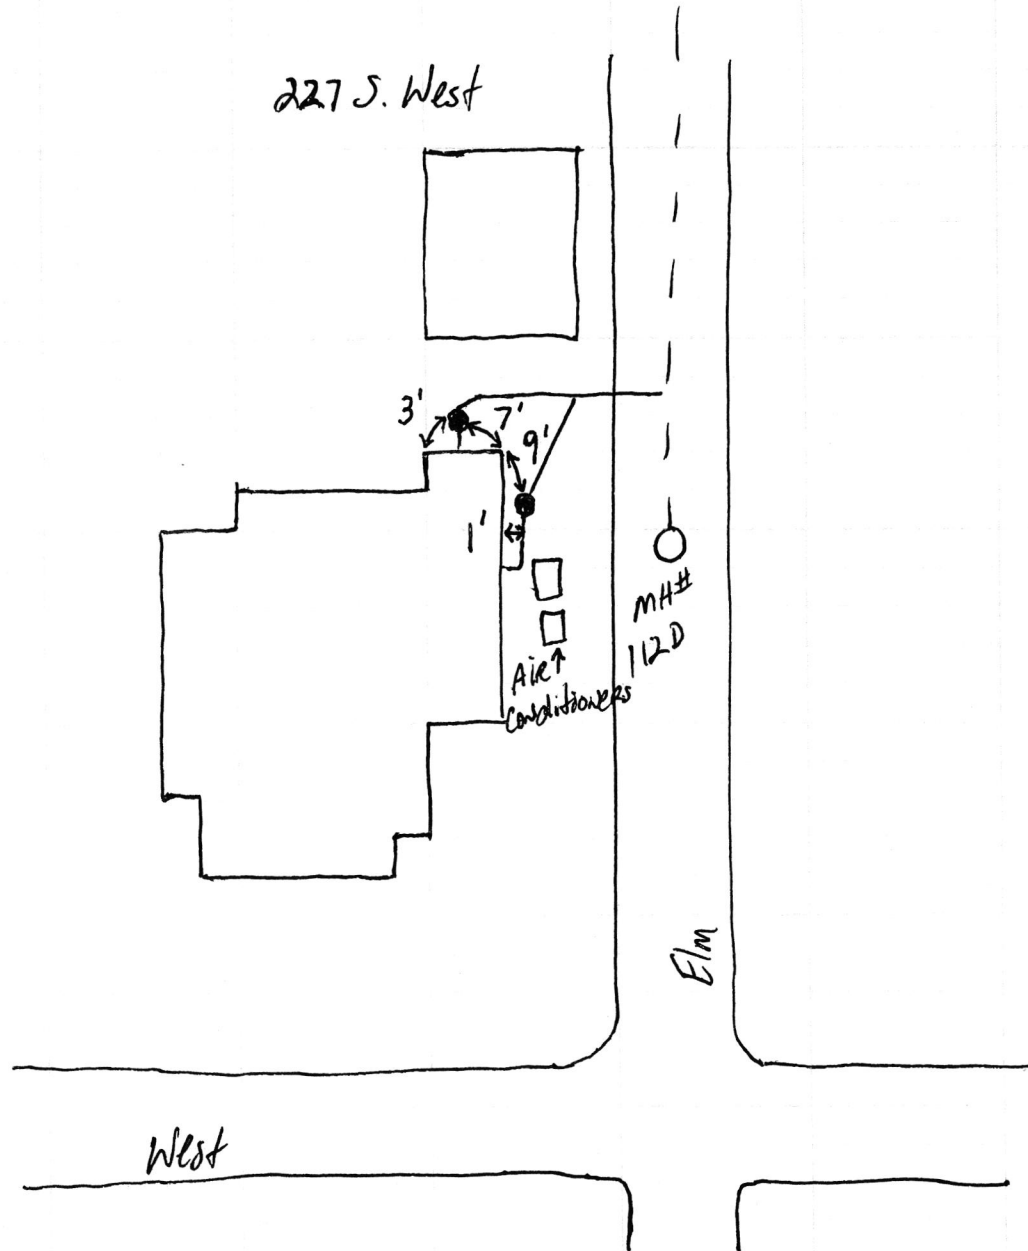

aan S west ST

SRF Phase II



227 S West ST

SRF Phase II

