

Gidw.


PROJECT Phase II SHEET _____ OF _____

SUBJECT _____ DATE 3-5-18

JOB NO. 4447

BY Atlas

228 E. High

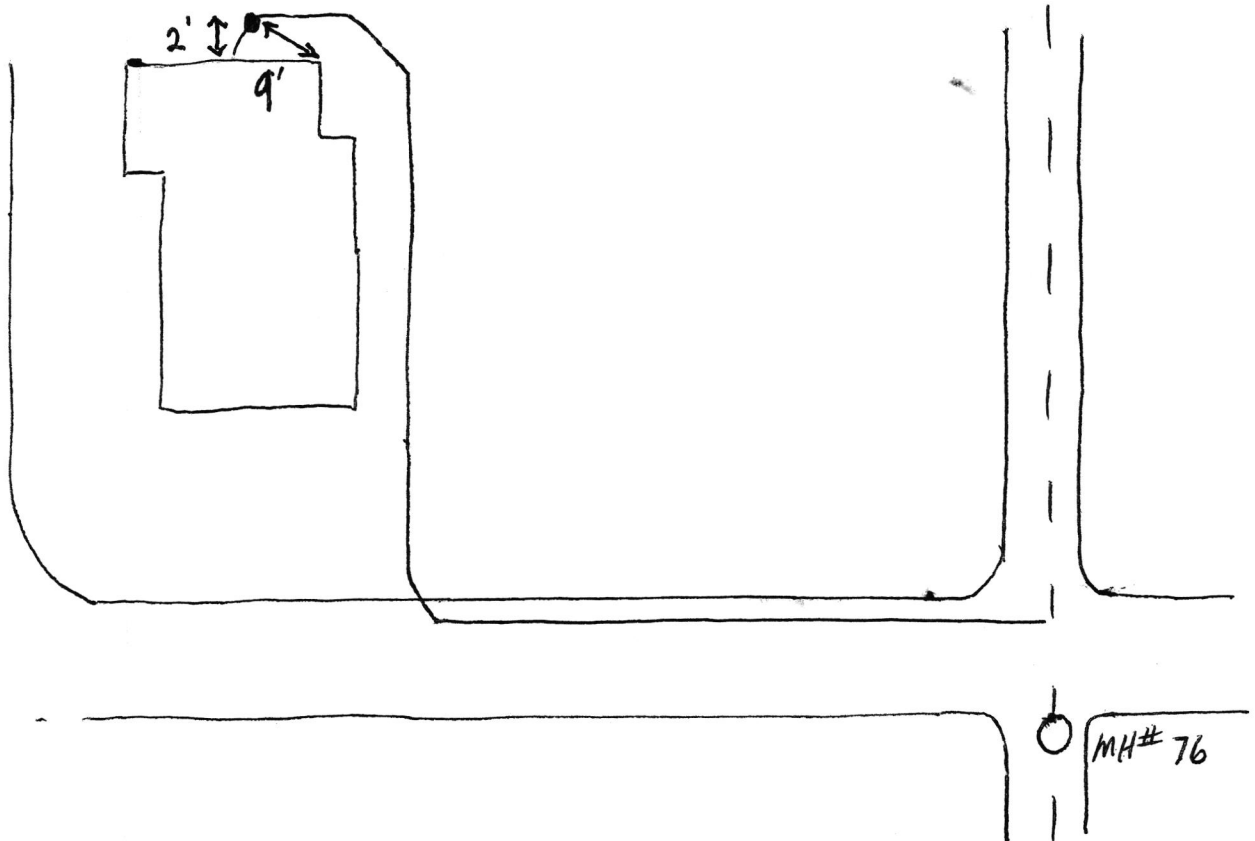

228 E High

SRP Phase II

