

GILW.

PROJECT

Phase II

SHEET

OF

SUBJECT

DATE


7-3-18

JOB NO.

4447

BY

ALIAS

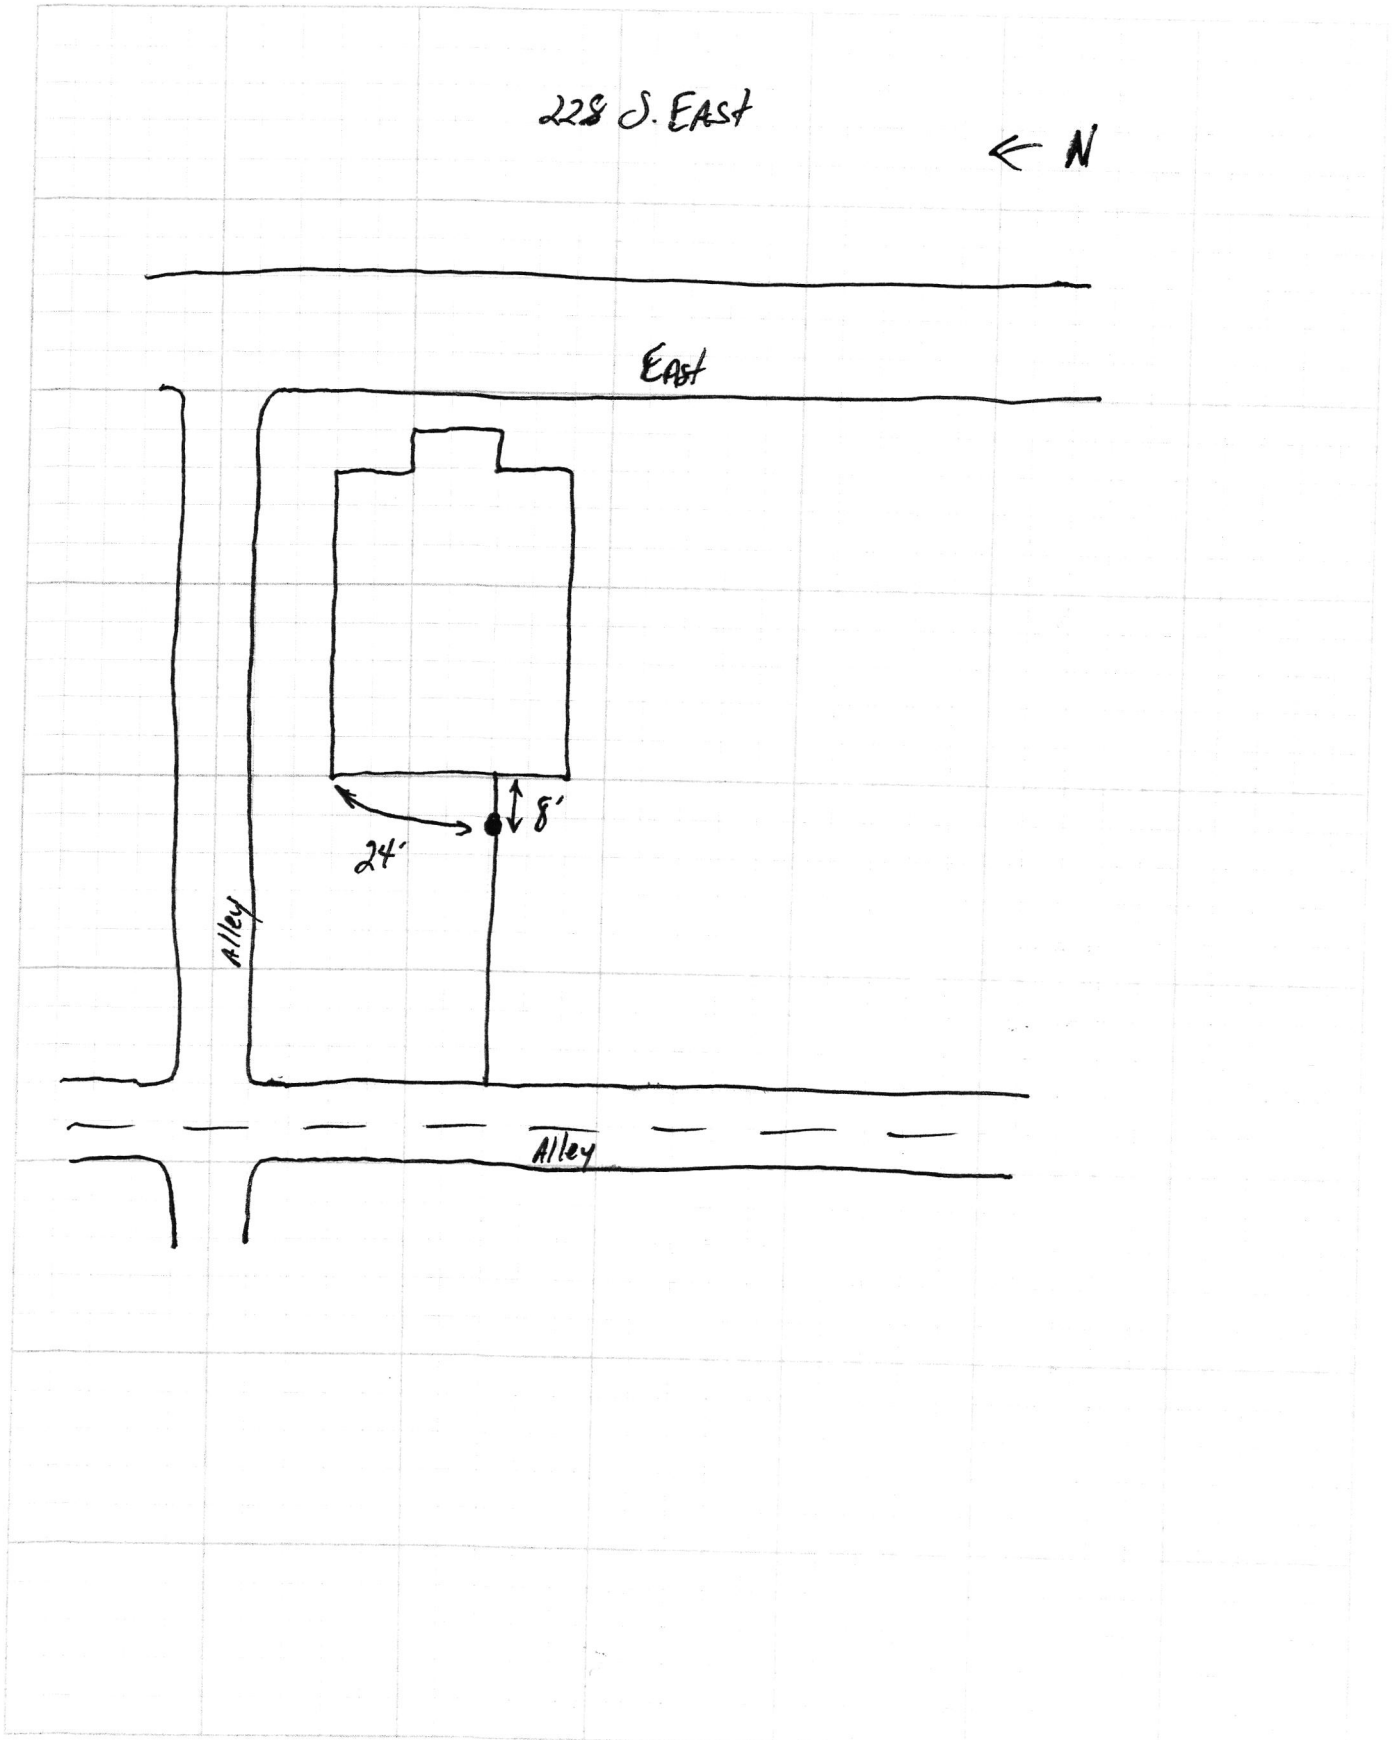

208 East

SPT Phase II

7.10.18

