

Gidw.

PROJECT Phase II SHEET _____ OF _____

SUBJECT _____ DATE 7-18-18


JOB NO. 4447

BY Atlas

228 S. Pearl

← N

Pearl

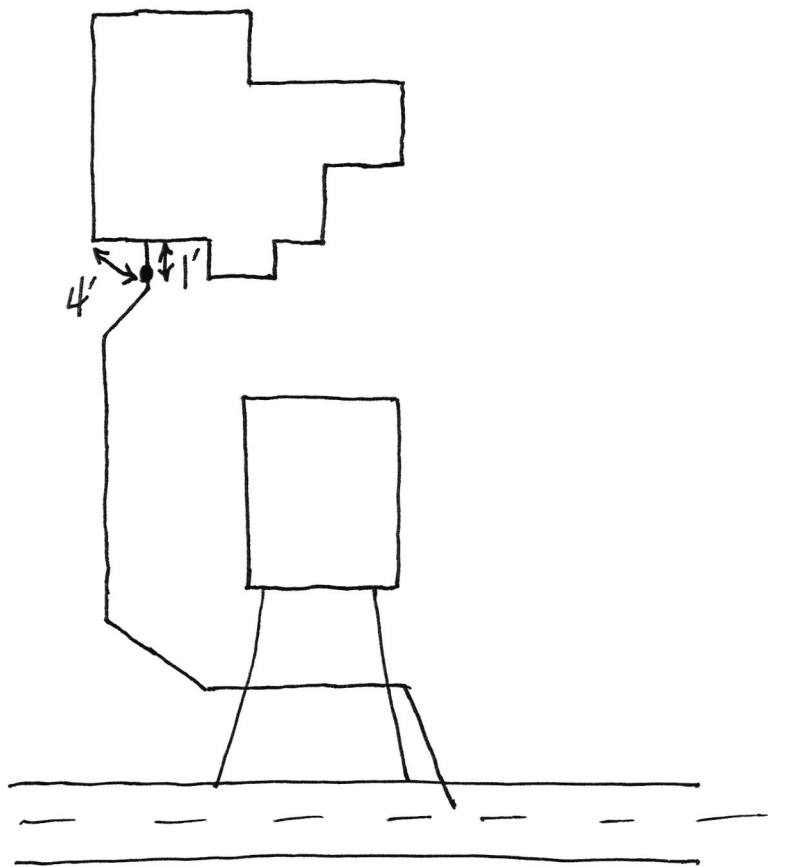

228 S Pearl

SRF Phase II

7-30-18

