

Gidw.


PROJECT Phase II SHEET _____ OF _____

SUBJECT _____ DATE 4-5-18

JOB NO. 4447

BY Atlas

229/231 Jefferson

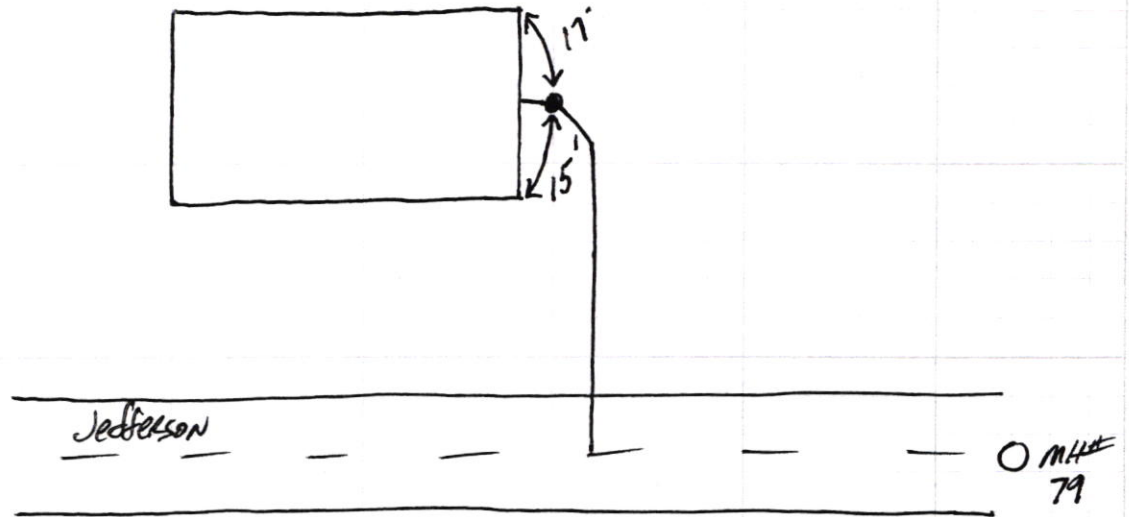

229-231 S Jefferson

SHP
Phase II

4.11.18

