


Gidw.

PROJECT Phase II SHEET _____ OF _____

SUBJECT _____ DATE 3-19-18

JOB NO. 4447

BY Atlas

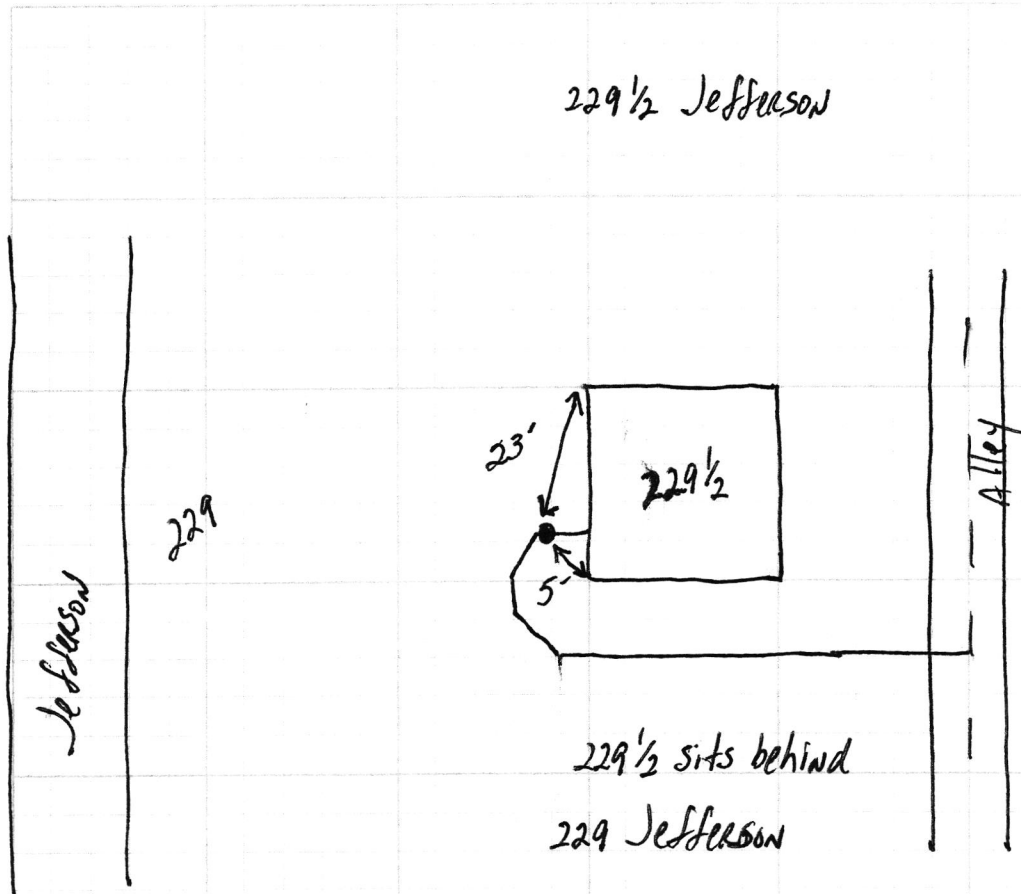

229 1/2 S Jefferson

SRP Phase II

