


Gidw.

PROJECT Phase II SHEET _____ OF _____
SUBJECT _____ DATE 4-16-18
JOB NO 4447
BY AH/AS

229 W. High

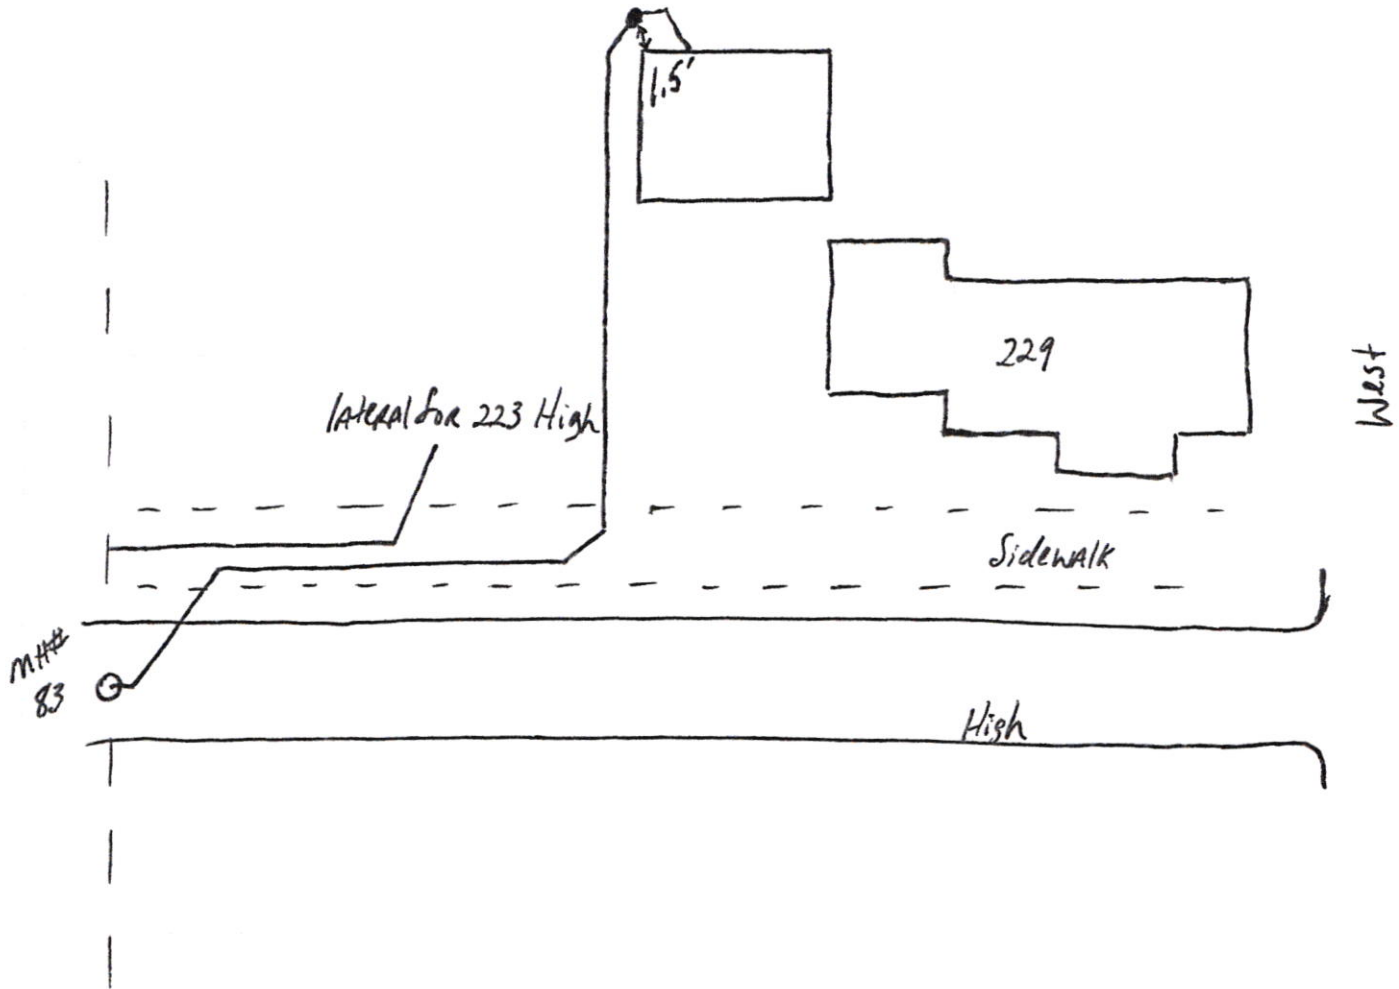

229 w High

SRF
Phase II

4.20.18

