

Gidw.


PROJECT Phase II SHEET _____ OF _____

SUBJECT _____ DATE 2-6-18

JOB NO. 4447

BY Atlas

229 W. Taylor

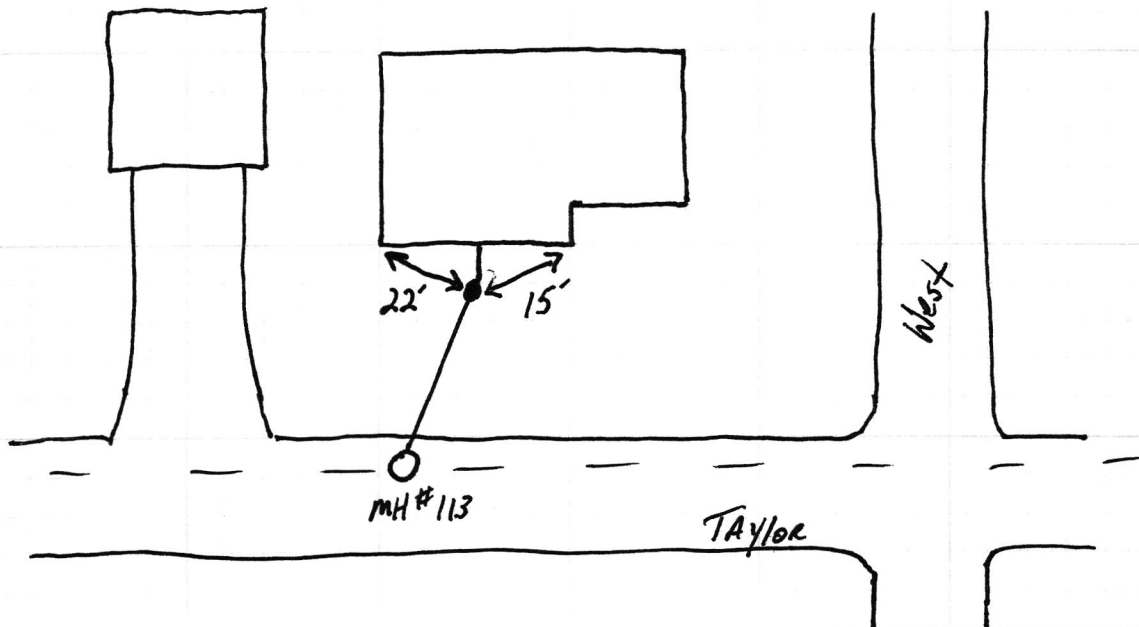

229 W Taylor

SRF Phase II

