

Gidw.


PROJECT Phase II SHEET _____ OF _____

SUBJECT _____ DATE 6-2-18

JOB NO. 4447

BY ATLAS

230 E. Clark

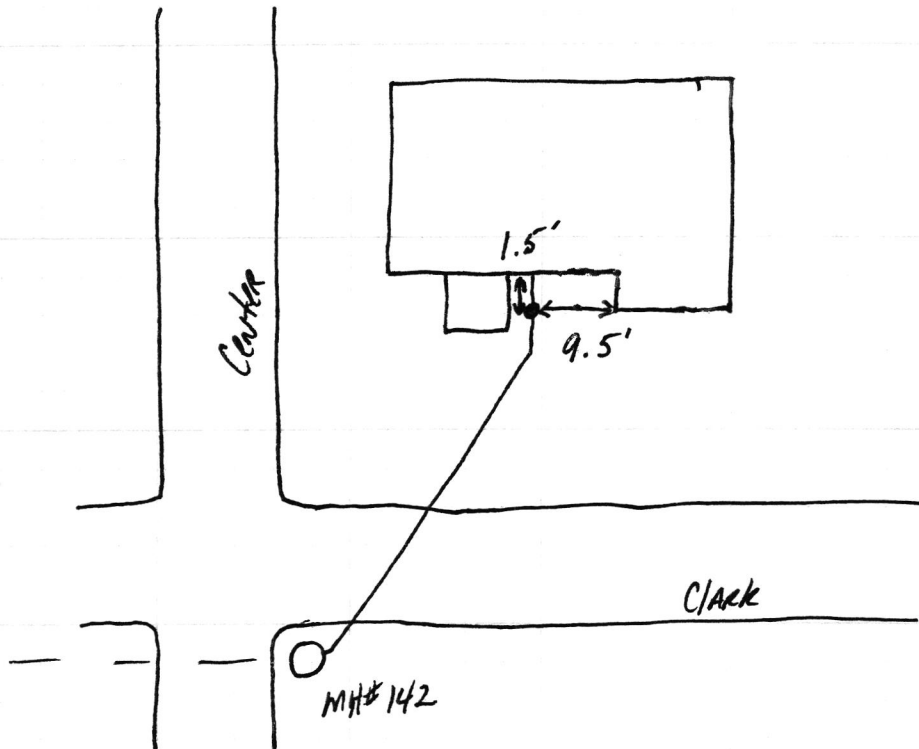

230 E Clark

SRP Phase II

6.11.18

