

Gidw.


PROJECT Phase II SHEET _____ OF _____

SUBJECT _____ DATE 4-10-18

JOB NO. 4447

BY AL/as

230 S. Jefferson

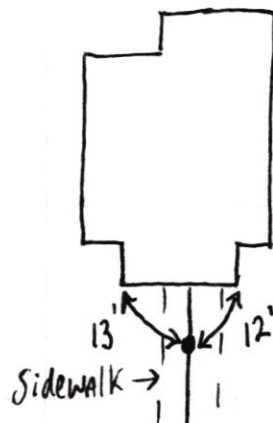

230 S Jefferson

SRP
Phase II

4.11.18

