


Gidw.

PROJECT Phase II SHEET _____ OF _____

SUBJECT _____ DATE 2-12-18

JOB NO. 4447

BY Atlas

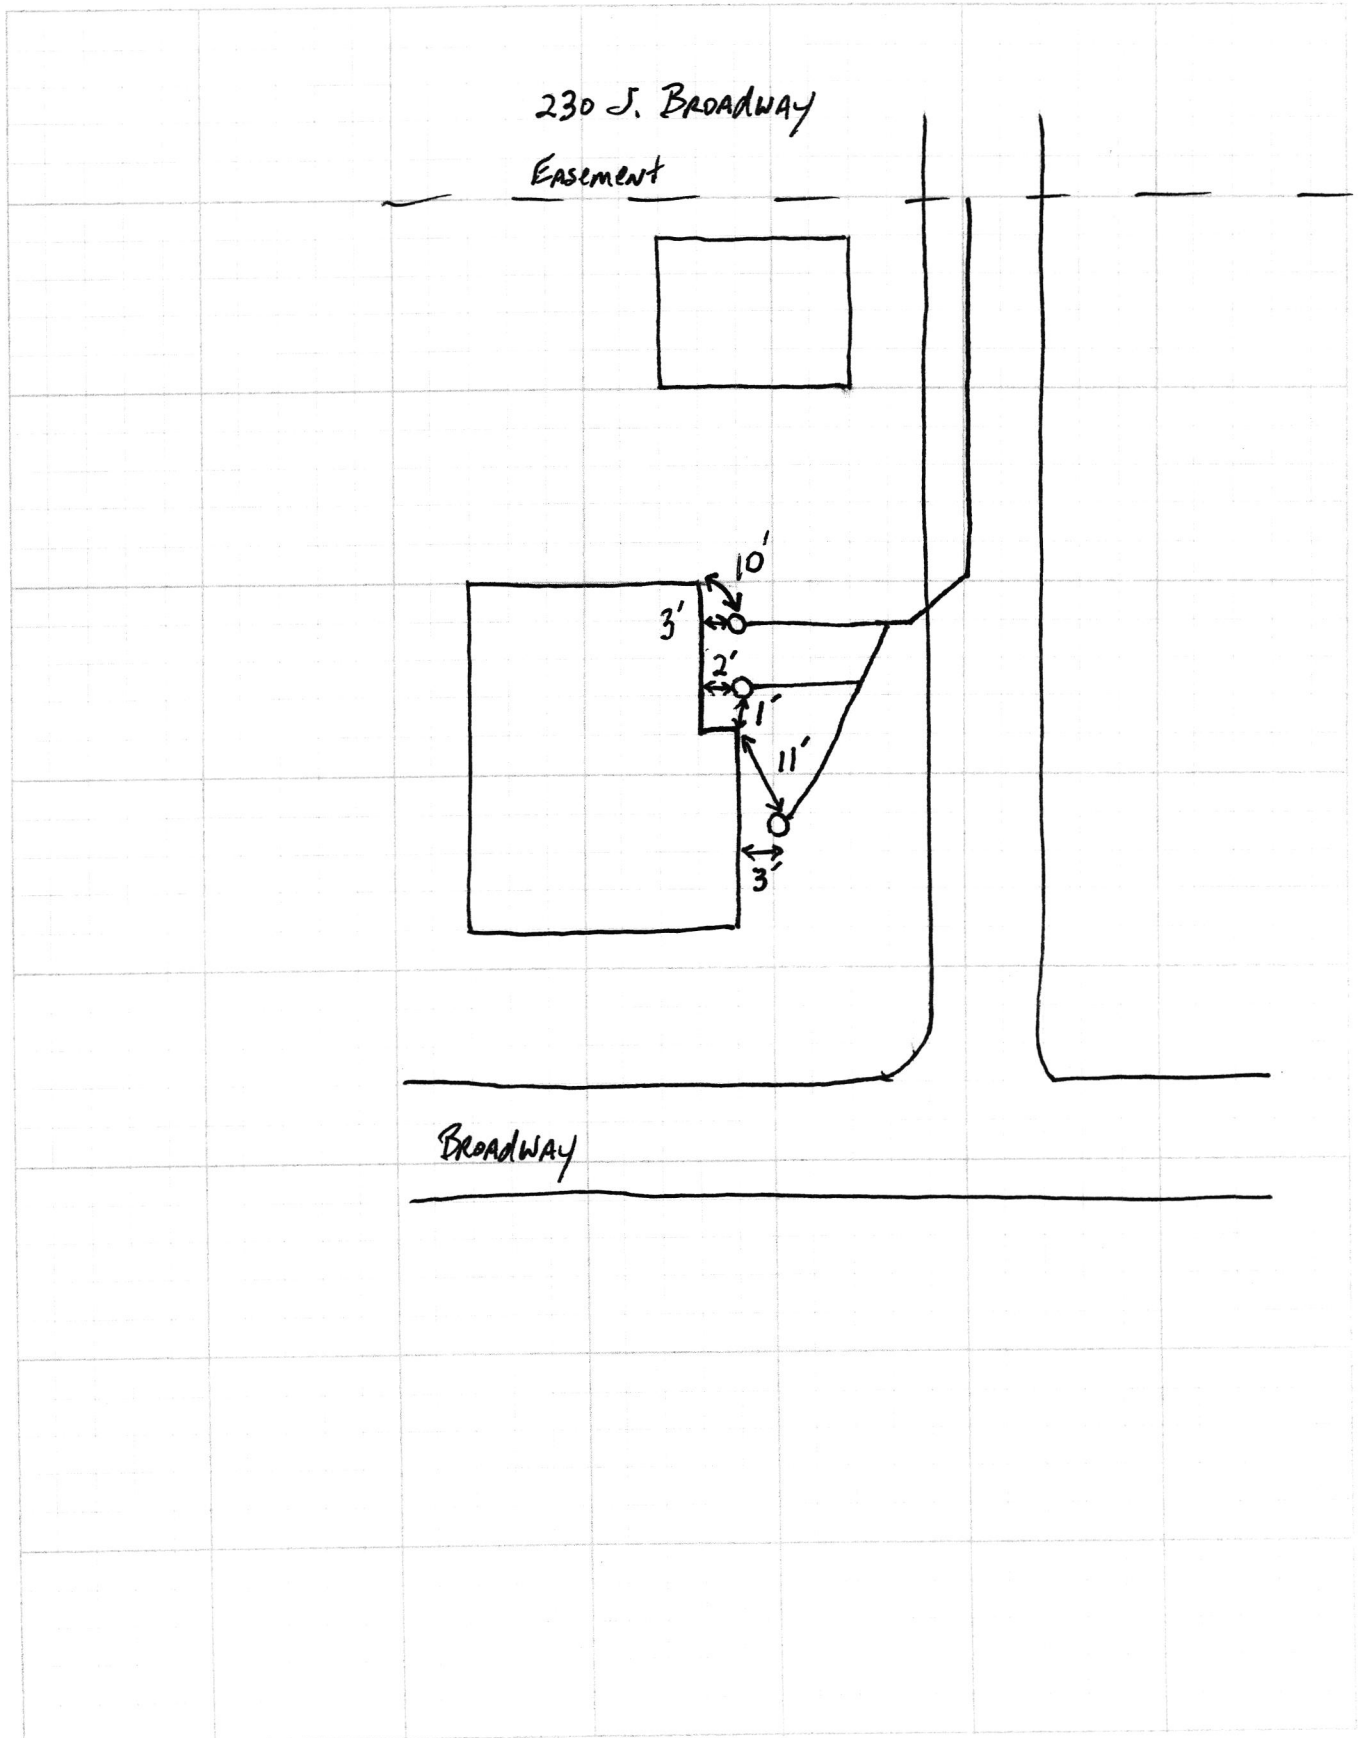

230 S Broadway SRP Phase II



230 S Broadway

SRP Phase II

