

Gidw.

PROJECT Phase II SHEET _____ OF _____


SUBJECT _____ DATE 5-15-18

JOB NO. 4447

BY AHAS

230 W. High

N →

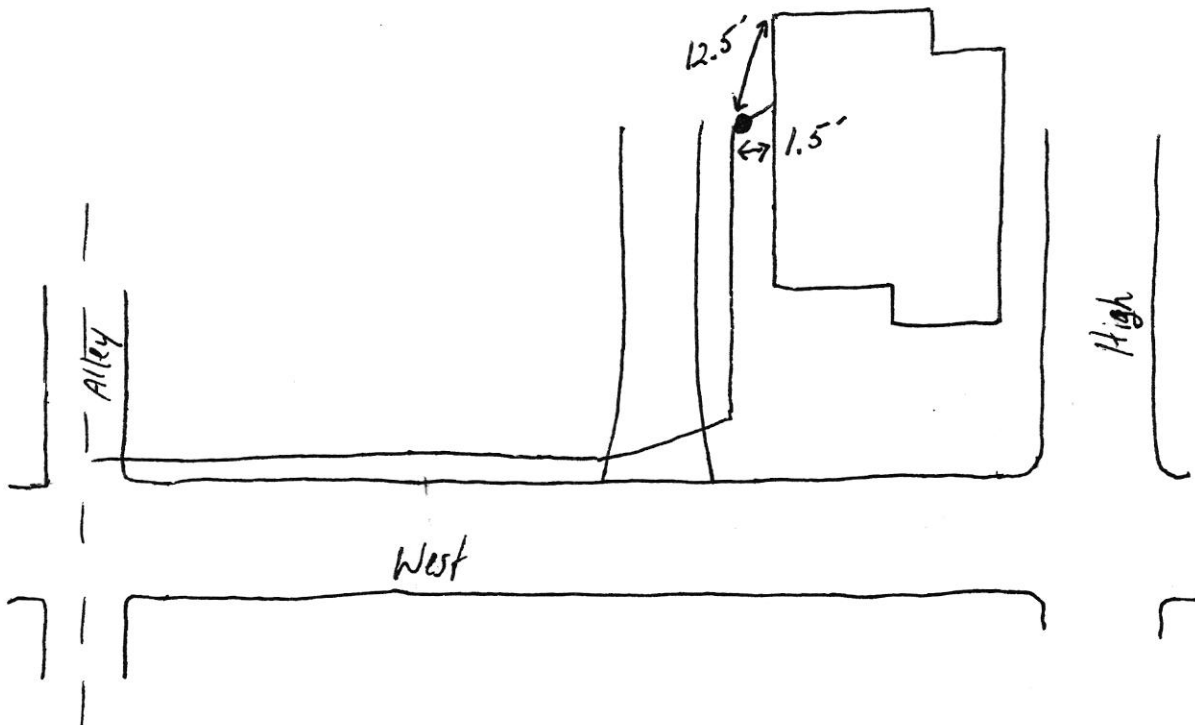

330 W High

S&P Phase II

5.22.18

