



FALL CREEK REGIONAL WASTE DISTRICT

9378 S. 650 West PO Box 59
Pendleton, IN 46064-0059 778-7544

Contractor: Tom Davis

APPLICATION FOR SEWER PERMIT

No 2601

Date 9/9/98

Permit Void 90 days from Date of Issuance

Owner Name Doug BowmerProperty Address 231 E US 36

Lot # _____ P.O. Box _____

Town Pendleton, IN Zip Code 46064Phone _____ City Water _____ Well ☒

\$ 400.00 Tap on Fee Paid net # 6152 Mrs. Doug Bowmer
\$ _____ Inspection fee paid paid for grinder pump
on 10/4/00

Application is hereby made for connection to the Fall Creek Regional
Waste District Sewer System for the above listed property - Permit Type:
Residential ☒, Commercial _____, Industrial _____, or Governmental/
Institutional _____. User Information _____.

All workmanship and materials shall conform to the standards of the
District Ordinance as described in Ordinance 84-2 and 84-3 as amended.
Acceptance and approval must be made by the District inspector or his duly
authorized representative before backfilling and final connection is made
to the main sewer lines. Any violation of applicable regulations will
cause all lines and appurtenances in violation to be removed and replaced
at the owners expense.

The Fall Creek Regional Waste District is responsible for the inspection,
approval of materials, and installation techniques only. All costs for
materials and installation and any liabilities resulting from same is the
sole responsibility of the property owner.

I have read and fully understand the above provisions and agree to
comply by said provisions.

Doug Bowmer
APPLICANT(S) SIGNATURE

INSPECTOR BDate inspected 10/4/00 Approved ? Rejected _____


Reason for rejection _____

Date reinspected _____ Approved _____ Rejected _____

Notes:

Size Pipe 4 "Type Pipe Sch 40 Glue ?Basement Yes _____ No ☒Sump Pump Yes _____ No ☒Downspout to Ground Yes ☒ No _____Septic Tank Pumped & filled Yes _____ No ☒Contractor Tom DavisSpecial Conditions Inspected E.M. onlyNo Final inspection was madeExisting Home ☒

New Construction _____

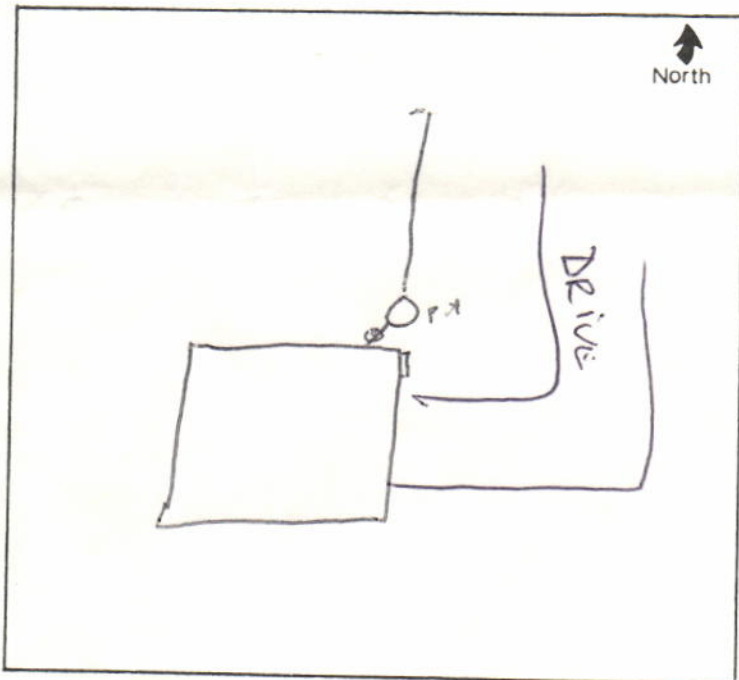

DOUG BOWMER
WILMA BOWMER
231 E. HWY. 36
PENDLETON, IN 46064-9012

71-1677749

DATE 10-4-06PAY
TO THE
ORDER OF*Stan ^{WB} Campbell Regional Waste*\$ 1024.70*One Thousand Twenty Four Dollars & ⁷⁰/₁₀₀*DOLLARS  Security watermark
Included
Check on back

STAR
FINANCIAL
BANK

ANDERSON • ELWOOD • PENDLETON
CARMEL • INDIANAPOLIS, INDIANA

FOR

Wilma Bowmer

MP

⑈000342⑈ ⑆074901672⑆

DOUG BOWMER
WILMA BOWMER
231 E. HWY. 36
PENDLETON, IN 46064-9012

376

71-167/749

DATE 3-13-01

PAY
TO THE
ORDER OF

Full Creek Regional Water

\$ 2156.00

Twenty One Thousand & Fifty Six Dollars

DOLLARS  Security Features
Included
Details on back



STAR
FINANCIAL
BANK

ANDERSON • ELWOOD • PENDLETON
CARMEL • INDIANAPOLIS, INDIANA

FOR

Doug Bowmer

⑈000376⑈ ⑆074901672⑆