


Gidw.

PROJECT Phase II SHEET _____ OF _____

SUBJECT _____ DATE 3-26-18

JOB NO. 4447

BY Alas

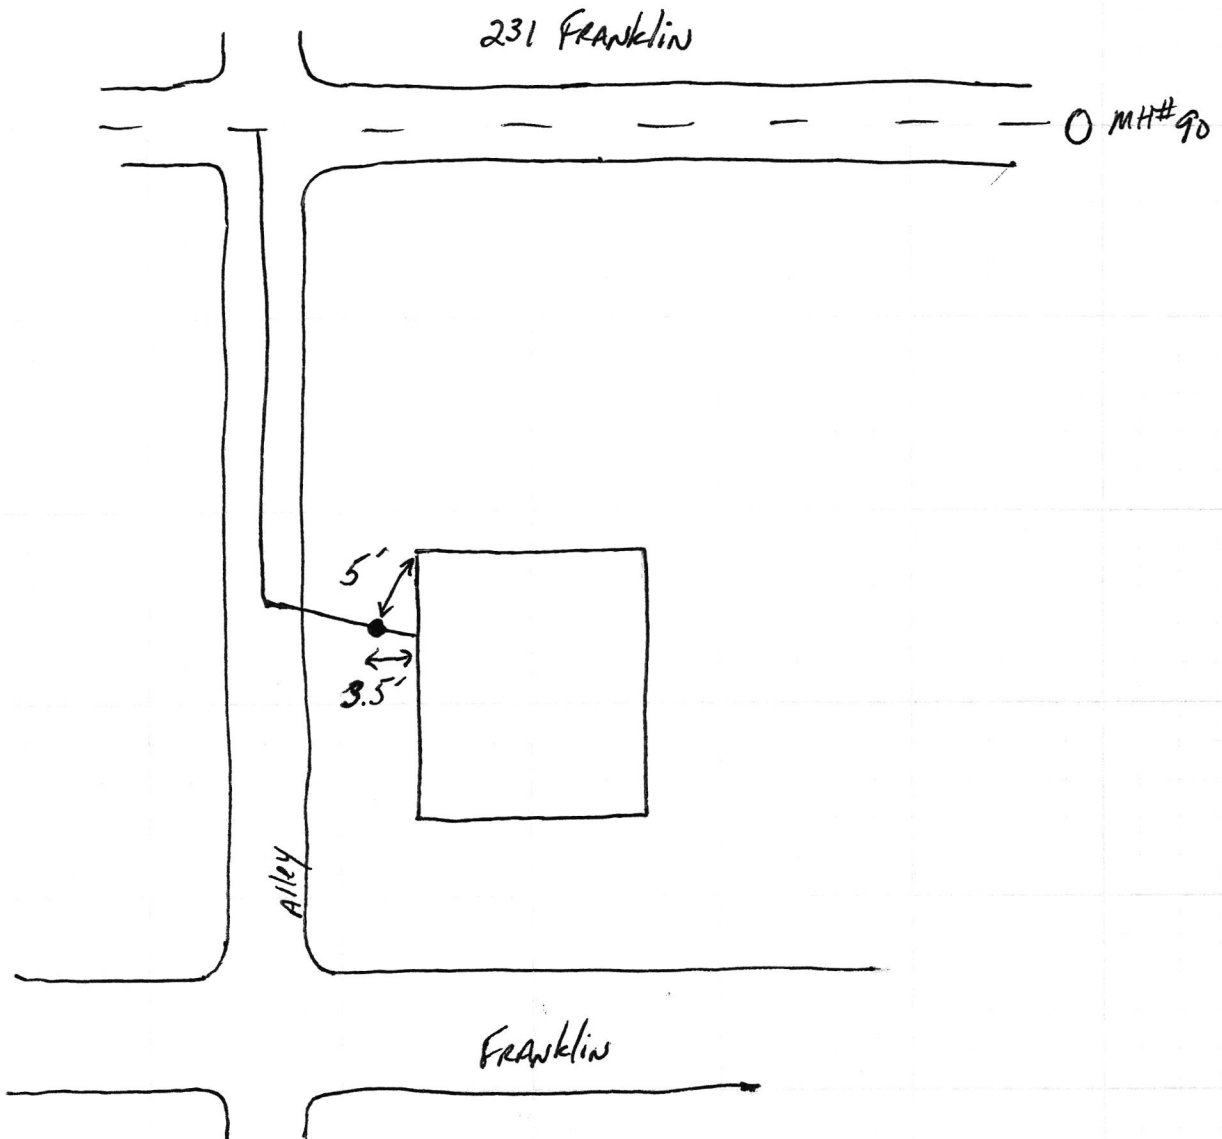

231 Franklin

SHP Phase II

