

*Gidw.*

PROJECT

PHASE II

SHEET

OF

SUBJECT

DATE

7-2-18


JOB NO

4447


BY

ATLAS

231 PEARL ST.

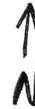

PEARL ST.

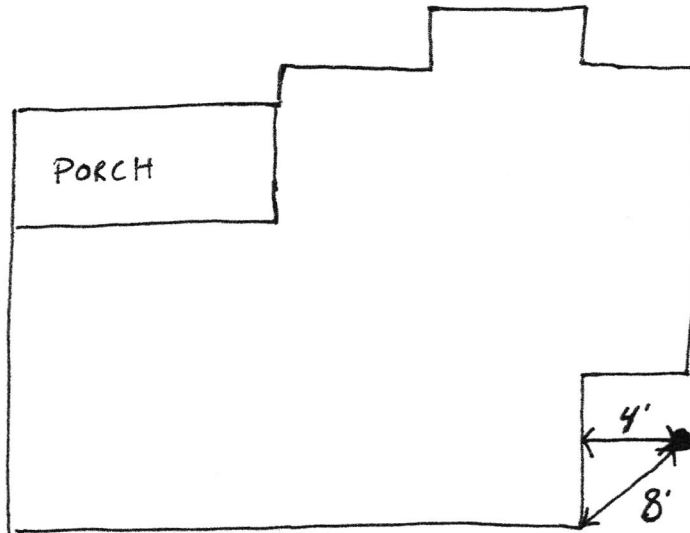

ALLEY



231 Pearl

SPT Phase II

7.6.18

