


Gidw.

PROJECT Phase II SHEET _____ OF _____

SUBJECT _____ DATE 3-9-18

JOB NO. 4447

BY AHAS

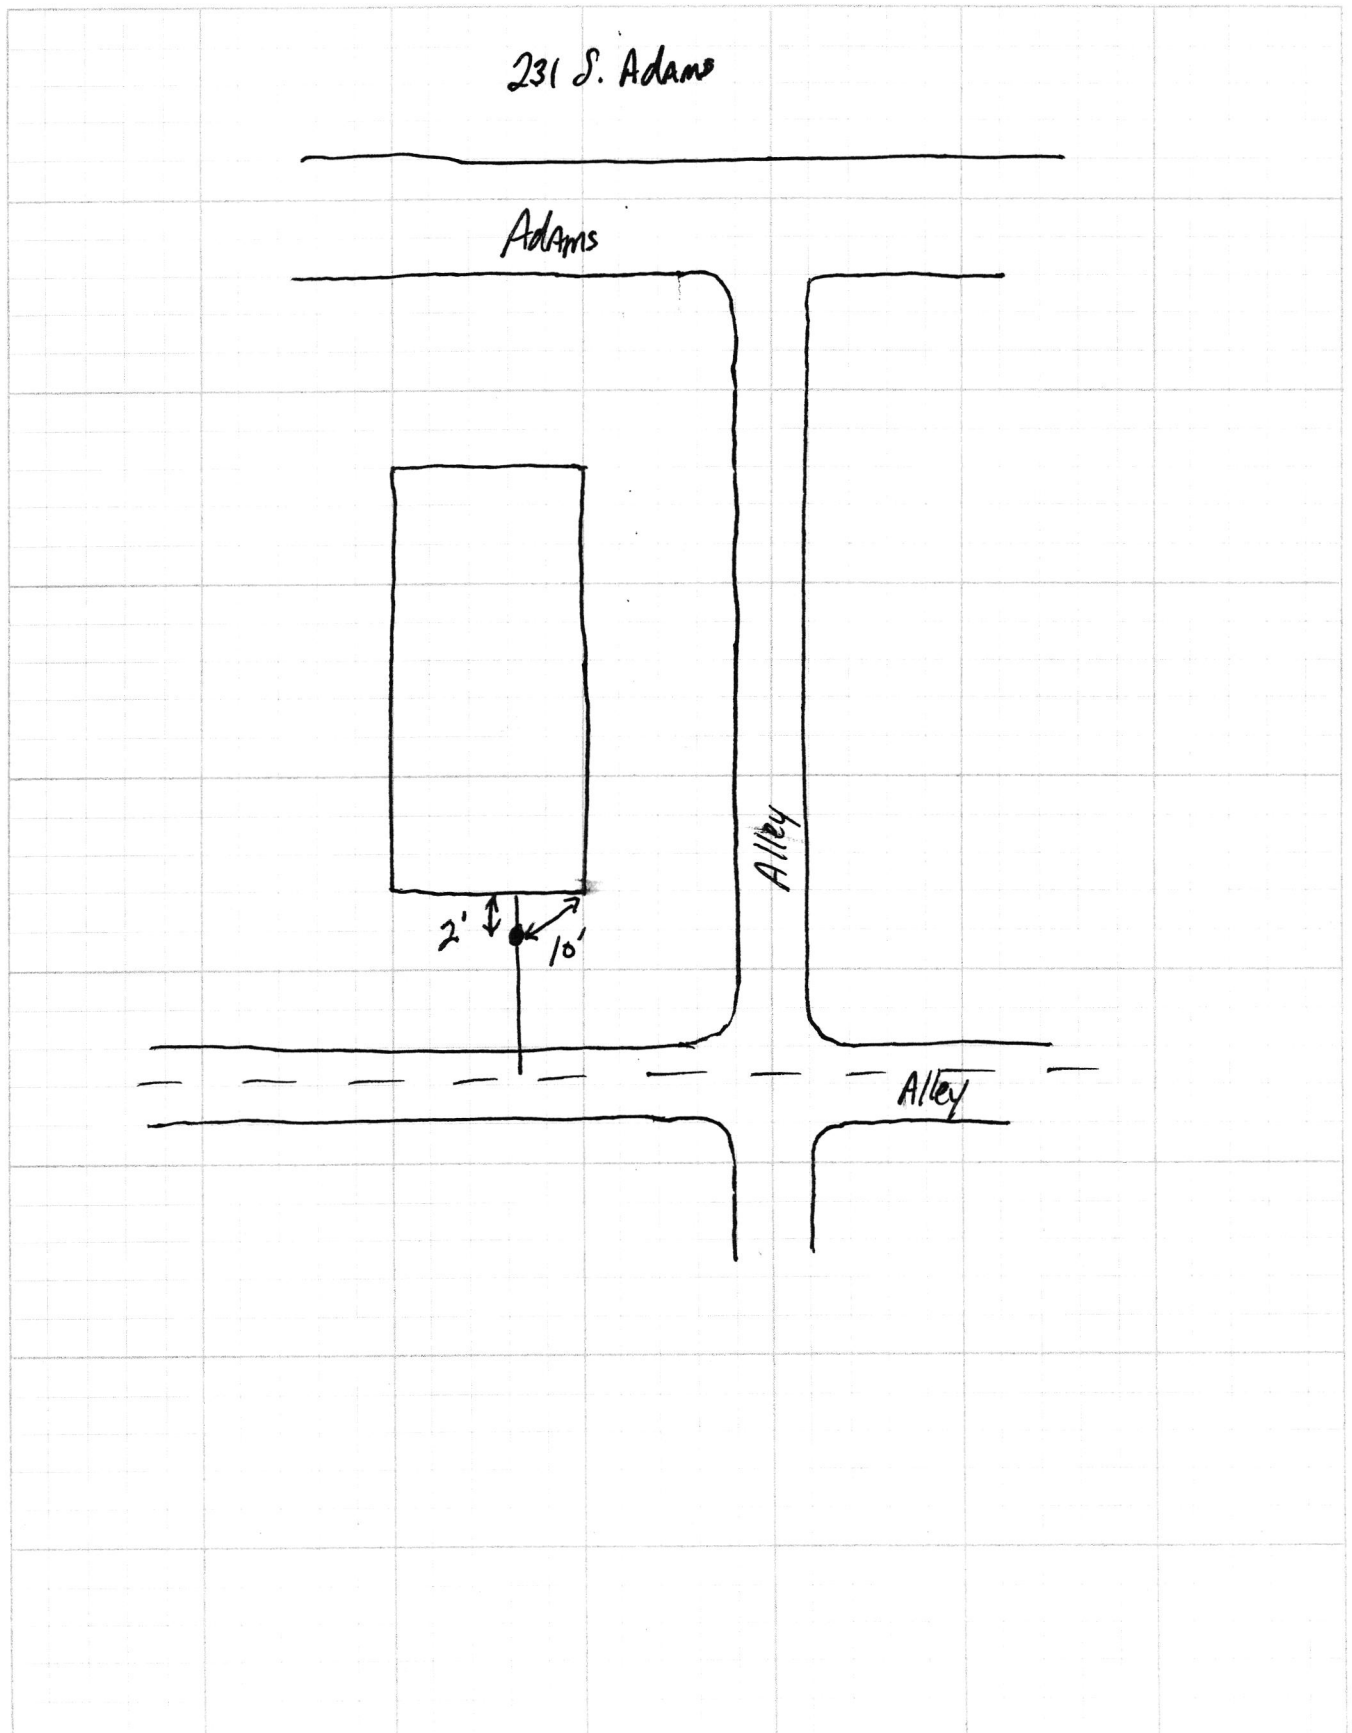

231 S Adams

SRP Phase II

