

Gidw.

PROJECT Phase II SHEET _____ OF _____


SUBJECT _____ DATE 8-3-18

JOB NO. 4447

BY Atlas

231 S. Pendleton

N →

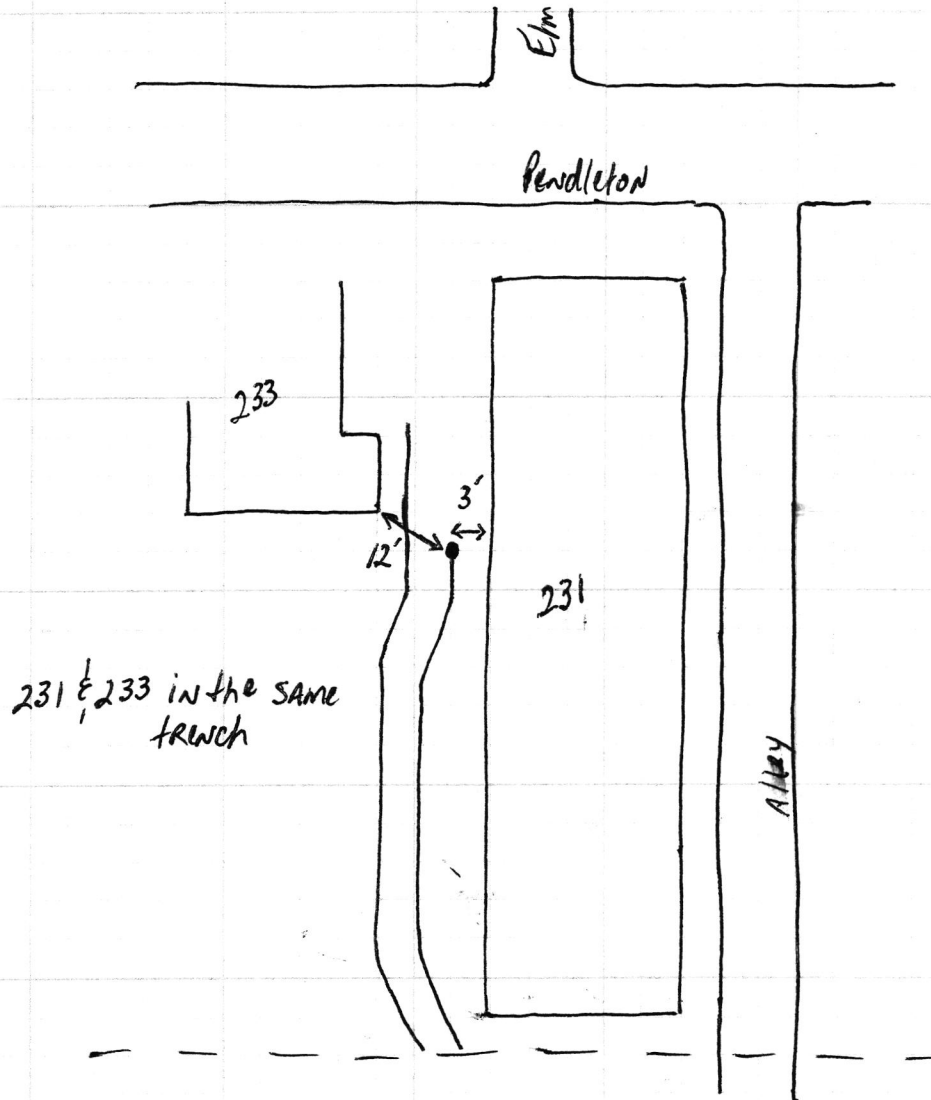

231 S Penelluon

SPE Phase II

8-15-18

