

Gidw.


PROJECT Phase II SHEET _____ OF _____

SUBJECT _____ DATE 5-2-18

JOB NO. 4447

BY Atlas

232 E. State

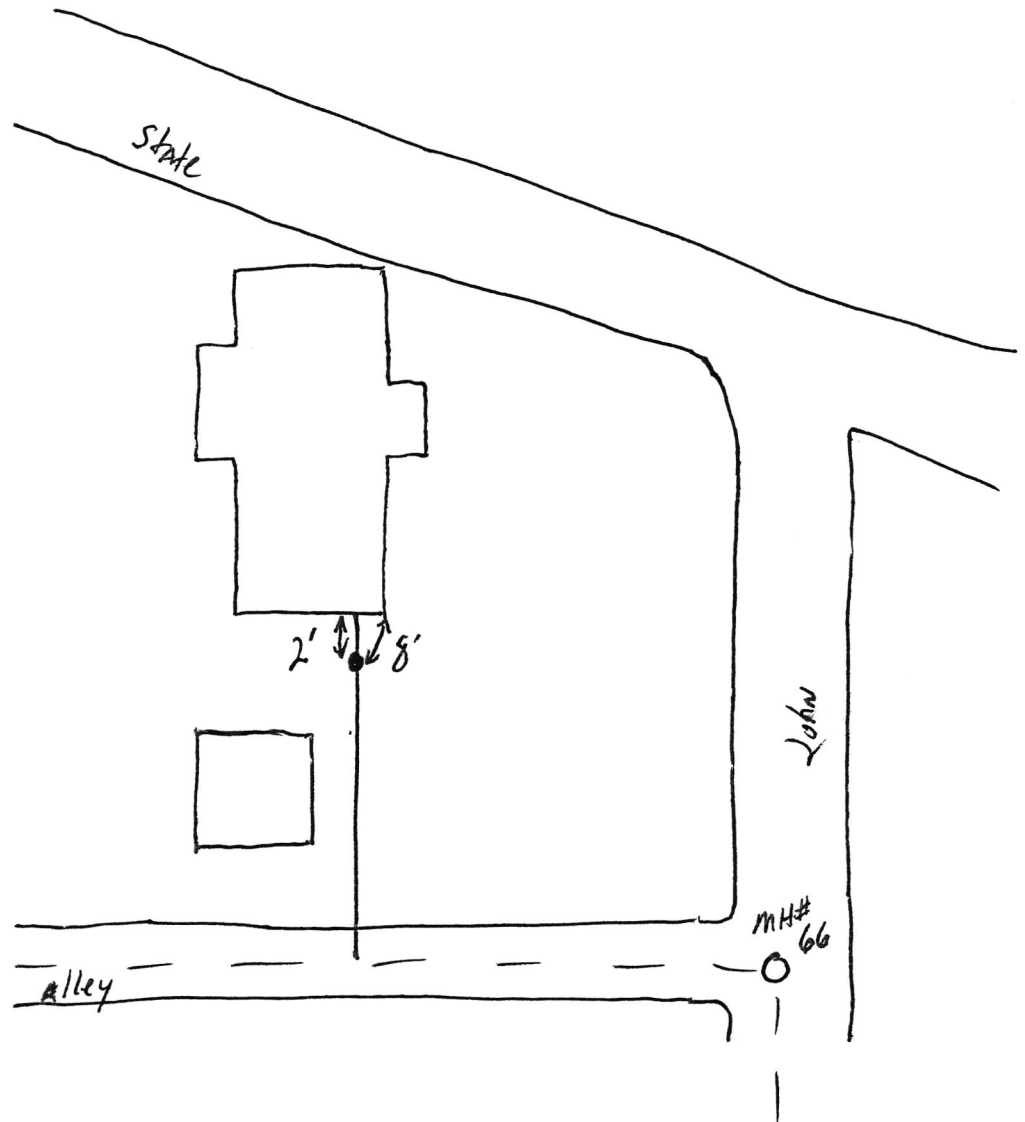

232 & State

SRF
Phase II

5.3.18

