


Gidw.

PROJECT Phase II SHEET _____ OF _____
SUBJECT _____ DATE 7-17-18
JOB NO. 4447
BY Atlas

232 S Pearl

← N

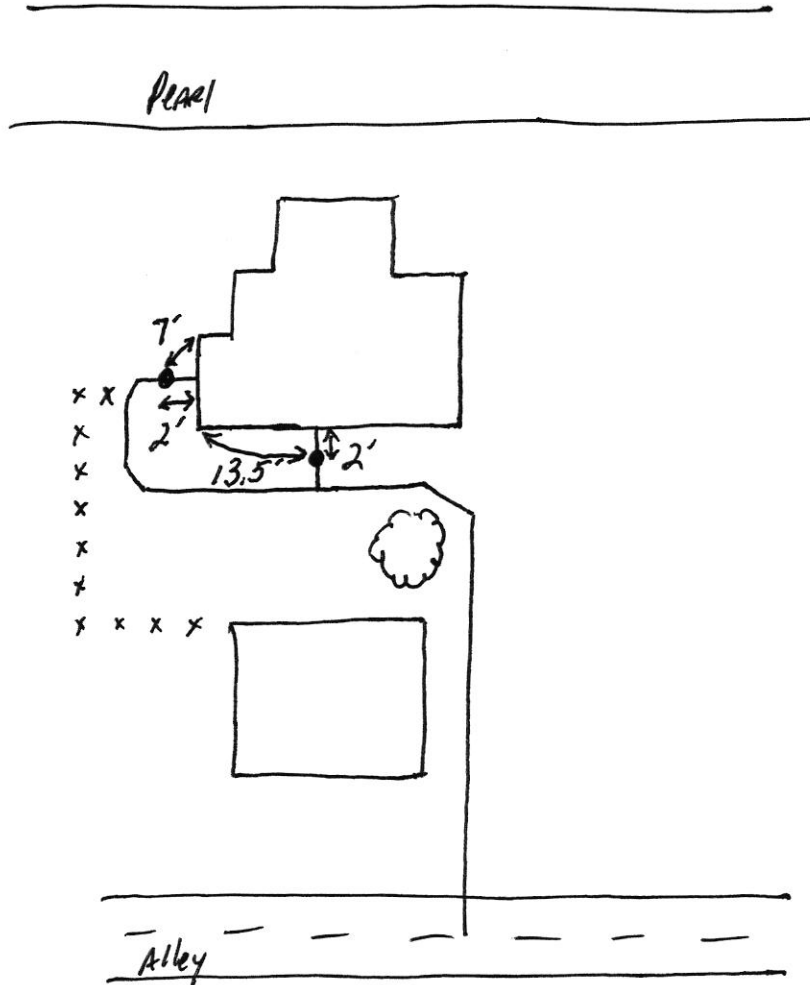

23a S Teat

SPT Phase II

7.30.18



23a S Pearl ST

SRF Phase II

7.18.18

