

Gidw.

PROJECT

Phase II

SHEET

OF

SUBJECT

DATE

3-22-18

JOB NO

4447

BY

Atlas


232 S. Adams

← N

Adams

Tim - replace original
with this one

The north
clean out is
under a
wooden ramp

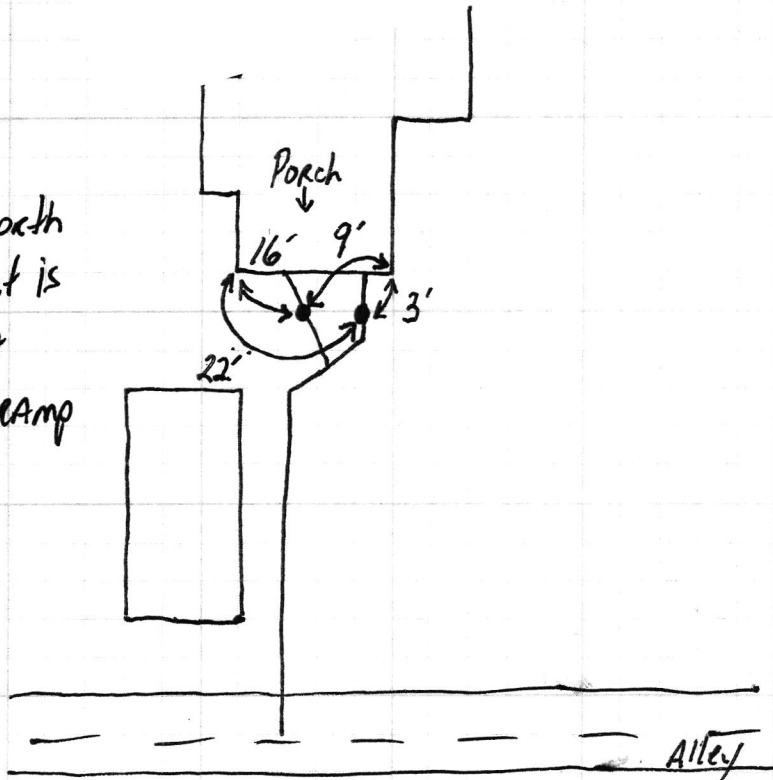

23a Adams

SAP Phase II



23a Adams

SRF Phase II

7.18.18



Gidw.

PROJECT Phase II SHEET _____ OF _____
SUBJECT _____ DATE 3-22-18
JOB NO. 4447
BY Atlas

232 S. Adams

Adams

