

Fall Creek Regional Waste District
9378 S 650 W, P.O. Box 59, Pendleton, IN 46064
765-778-7544

#8345

Agreement for Sanitary Sewer Service

This Agreement made and entered into this 11 day of December, 2023 between Fall Creek Regional Waste District ("District") and Michael Carpenter ("Applicant") regarding the provision of sanitary sewer service, and the assignment of capacity in and connection to, the District's facilities for the premises located at _____.

Street Address: 232 Western Blvd, Pendleton Anderson

Now therefore, the parties, in consideration of the mutual promises set out in this Agreement, the receipt and sufficiency of which is hereby acknowledged, agree as follows:

1. The Applicant agrees that all workmanship and materials shall conform to all District ordinances and the District's construction standards. District must accept and approve all work and materials before backfilling and final connection is made to the sewer mains. Any violation of this provision will cause all lines and appurtenances in violation to be removed and replaced at the Applicant's expense.
2. The District shall have the right to enter upon the Applicant's premises at all reasonable times to inspect, repair, or replace any equipment used in connection with the District's service or which has an impact on said service.
3. The Applicant shall be responsible for all monthly user rates, capacity charges, and tap fees. The failure to pay any rate charge or fee may result in a lien against the property and/or the termination of service to the property, the cost of which will be borne by Applicant, including, but not limited to, all attorney's fees and collection costs.
4. The District shall not be responsible for any damages as a result of any failure to supply service unless said damages are due to default, neglect or culpability on the part of the District.
5. If there is an available sanitary sewer within three hundred (300) feet of the property line, the property owner shall be required to connect to the District's sanitary sewer system.
6. The Applicant and District agree that the provision of sanitary sewer service touches and concerns the property and the terms of this Agreement bind the District and Applicant and their heirs, executors, administrators, personal representatives, successors, agents, attorneys, assigns, designees, and transferees.

The parties hereto have read and fully understand the above provisions and agree to comply with said provisions.

FALL CREEK REGIONAL WASTE DISTRICT
Rebecca Hunter
Signature

APPLICANT
Michael Carpenter
Signature

STATE OF INDIANA)
) SS:
COUNTY OF MADISON)

SUBSCRIBED and sworn to before me this ____ day of _____, 20__

My Commission Expires: _____ Signature _____


Printed _____
Notary Public
Resident of _____ County


Inspector John Date Inspected 11/08/24 Approved X Rejected _____
Reason for Rejection _____

Date Reinspected _____ Approved _____ Rejected _____

Notes:

Size Pipe 4 Type Pipe SR
Basement Yes No _____
Sump Pump Yes No _____
Downspout to Ground Yes No
Septic Tank Pumped & Filled Yes No _____
Contractor Fessler
Special Conditions _____
Existing Home X
New Construction _____

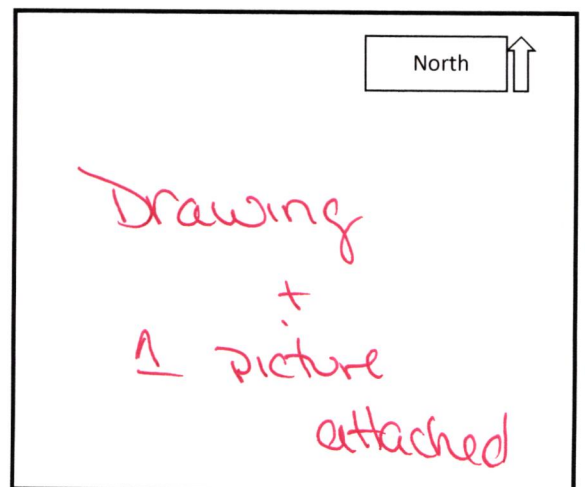

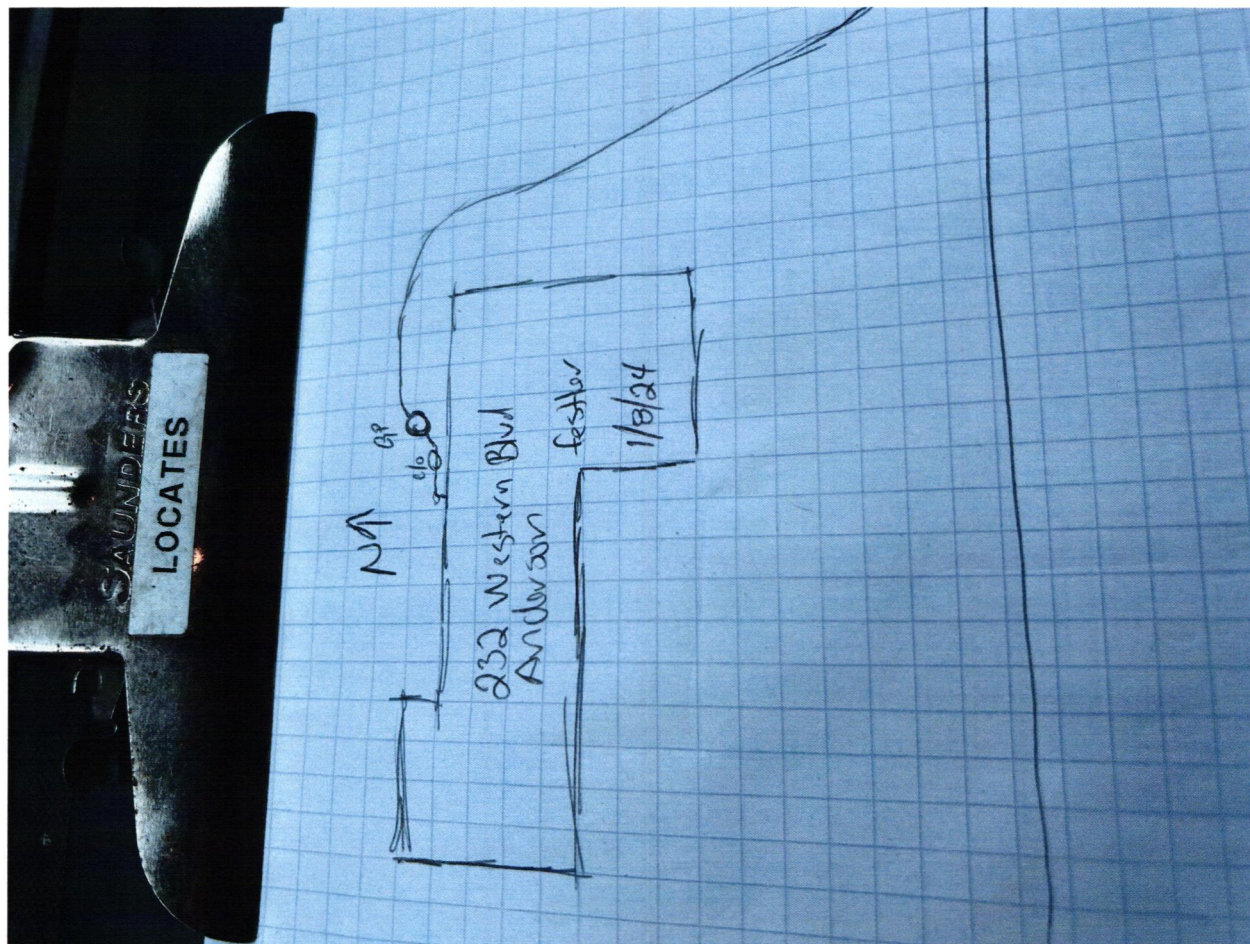



MICHAEL B. CARPENTER
MARTHA A. CARPENTER
232 WESTERN BLVD PH. 765-642-8730
ANDERSON, IN 46013

4788

71-167/749
101

Dec 11/23
DATE

PAY TO THE
ORDER OF

Fall Creek Regional Waste District

\$ 9,321.75

Nine Thousand Twenty Two & ~~75~~ DOLLARS



FOR

Fees Waste Water

Michael Carpenter MP

COPY

Capacity: \$3400.00

Tap: \$760.00

Grinder: \$5162.75

Unit: \$4825.00

Tax: \$337.75