

Gidw.



PROJECT Phase II SHEET _____ OF _____

SUBJECT _____ DATE 7-16-18

JOB NO. 4447

BY Atlas

233 E. High

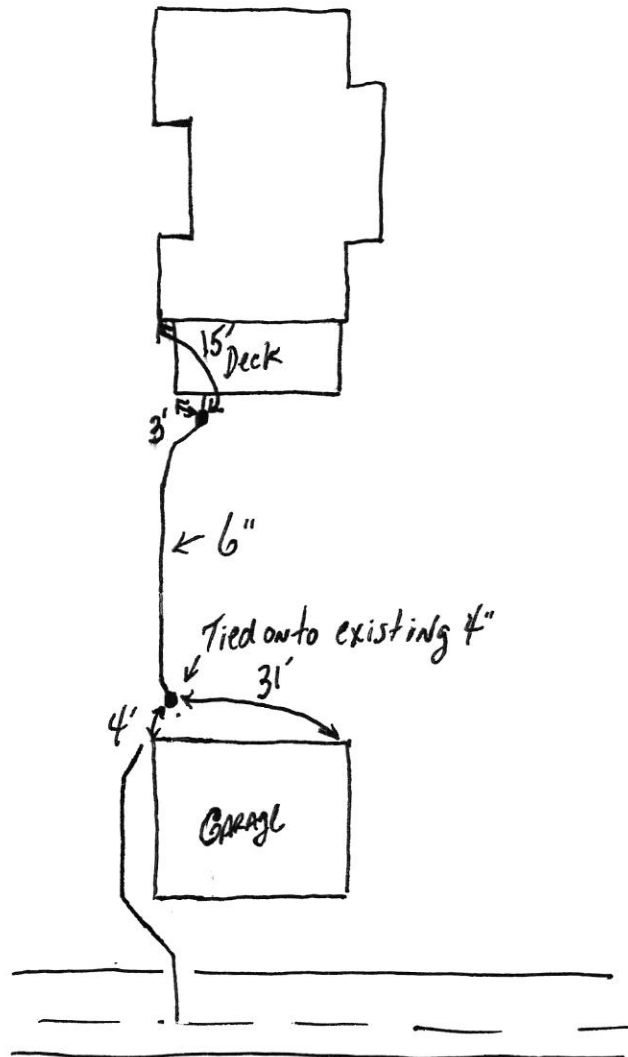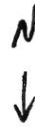

233 & High St

Sat Phase II

7.18.18



233 High

Sat Phase II

7.18.18

