


G&W

PROJECT Phase II SHEET _____ OF _____
SUBJECT _____ DATE 2-16-18
JOB NO. 4447
BY Atlas

233 S. MAIN

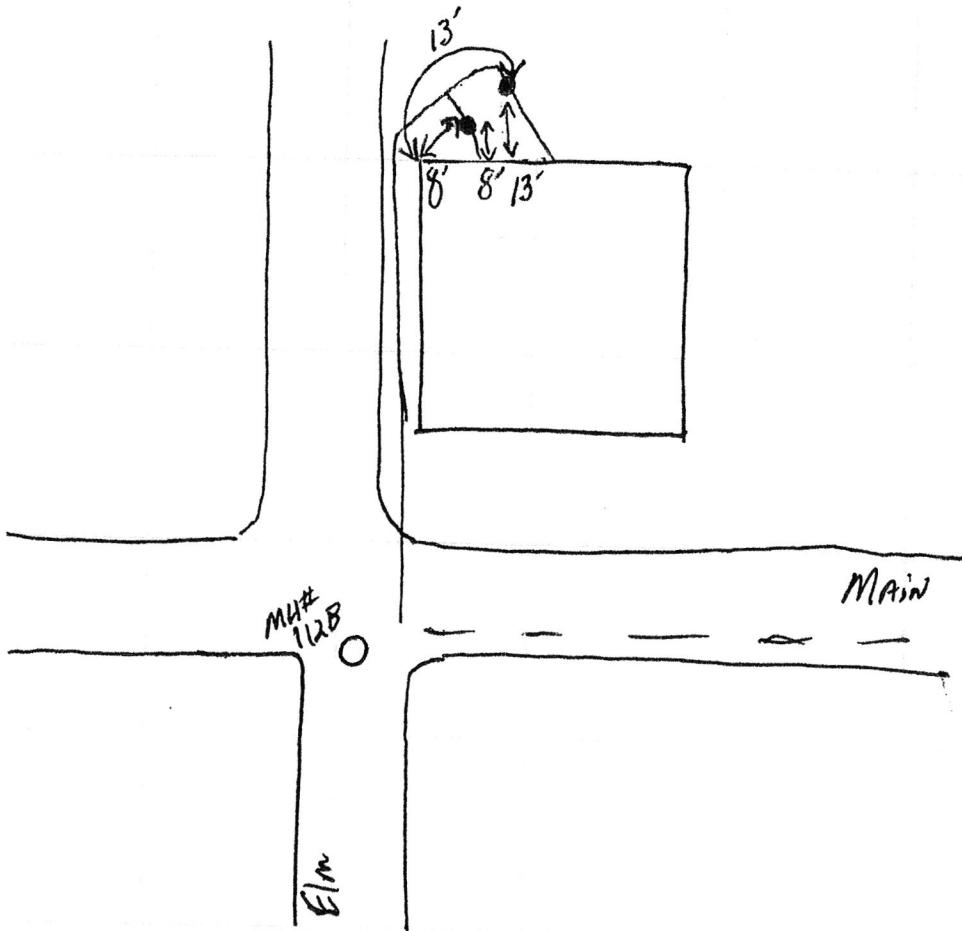

233 S Main

SRF Phase II

2018

