



FALL CREEK REGIONAL WASTE DISTRICT

9378 S. 650 West PO Box 59
Pendleton, IN 46064-0059 778-7544

3-06664.

APPLICATION FOR SEWER PERMIT

Nº 2760

Date

4/20/00

Permit Void 90 days from Date of Issuance

Owner Name

Robin Lee

Property Address

233 5 Pendleton Ave

Lot #

P.O. Box

Town

Pendleton

IN

Zip Code

46064

Phone

City Water

Well

\$

N/A

Tap on Fee Paid

\$

N/A

Inspection fee paid

lateral replacement

Application is hereby made for connection to the Fall Creek Regional Waste District Sewer System for the above listed property - Permit Type: Residential ☒, Commercial ☐, Industrial ☐, or Governmental/Institutional ☐. User Information

All workmanship and materials shall conform to the standards of the District Ordinance as described in Ordinance 84-2 and 84-3 as amended. Acceptance and approval must be made by the District inspector or his duly authorized representative before backfilling and final connection is made to the main sewer lines. Any violation of applicable regulations will cause all lines and appurtenances in violation to be removed and replaced at the owners expense.

The Fall Creek Regional Waste District is responsible for the inspection, approval of materials, and installation techniques only. All costs for materials and installation and any liabilities resulting from same is the sole responsibility of the property owner.

I have read and fully understand the above provisions and agree to comply by said provisions.

APPLICANT(S) SIGNATURE

INSPECTOR

B

Date inspected 4-20-00

Approved ☒

Rejected ☐

Reason for rejection

Date reinspected

Approved

Rejected

Notes:

Size Pipe 4" "

Type Pipe PVE

Basement Yes ☒ No

Sump Pump Yes No ☒

Downspout to Ground Yes ☒ No


Septic Tank Pumped & filled Yes No ☒

Contractor GARY FREDERICKS

Special Conditions

Existing Home ☒

New Construction

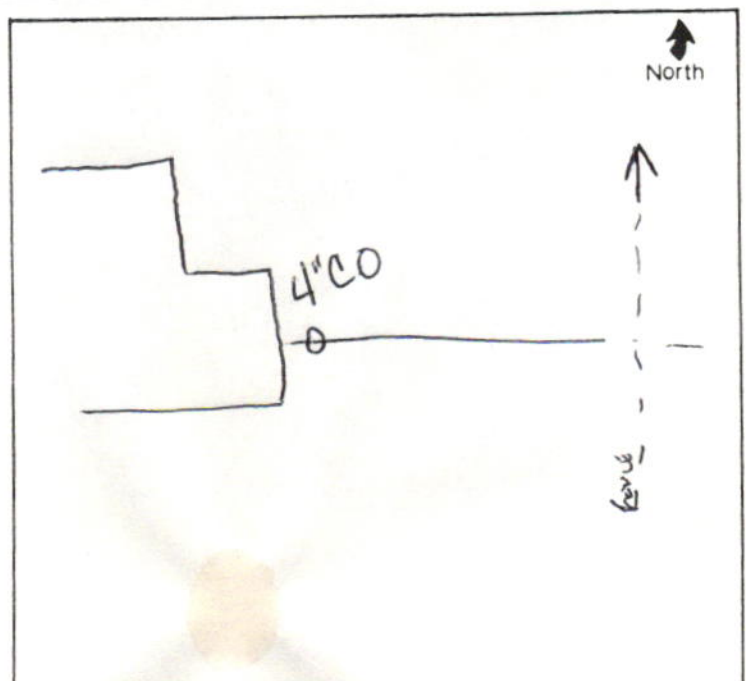

Gidw.

PROJECT Phase II SHEET _____ OF _____



SUBJECT _____ DATE 8-3-18

JOB NO. 4447

BY Atlas

233 S. Pendleton

N →

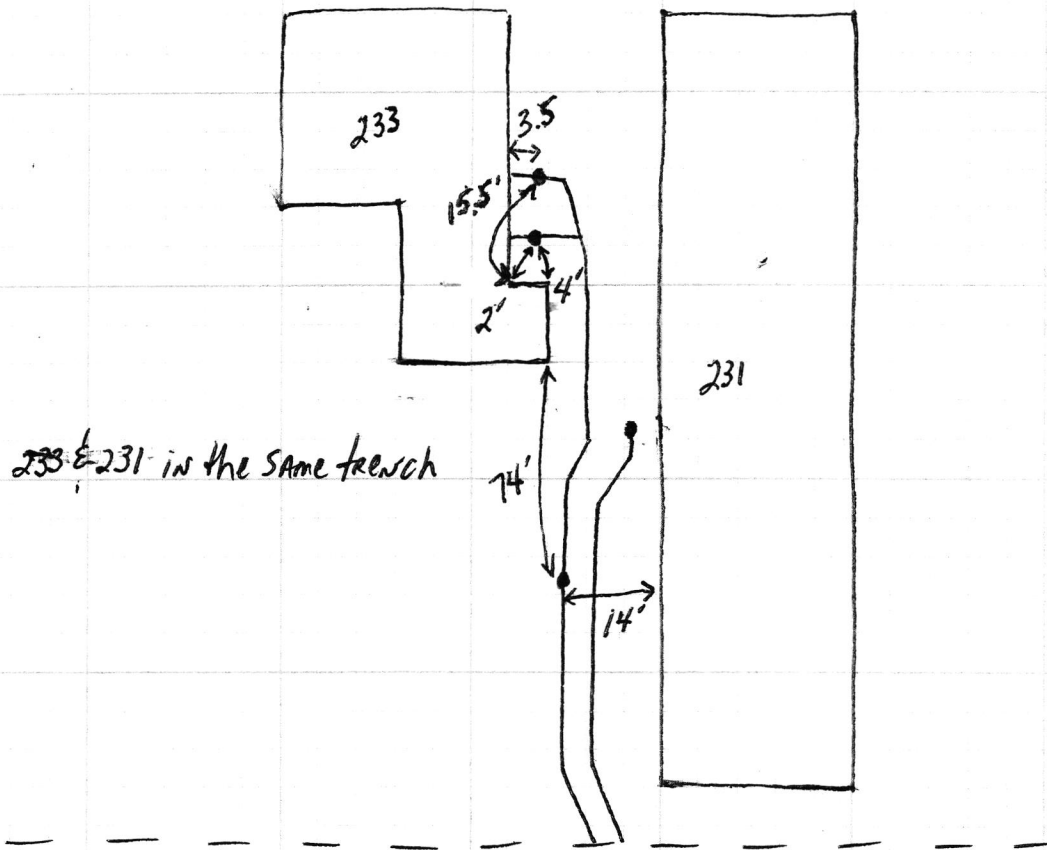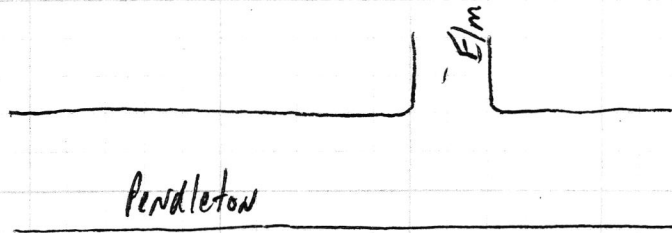

233 S Pendleton

SAP Phase II

8-15-18



033 S Pendleton

SRF Phase II

8-15-18



233 S ~~Front~~ Pendleton Ave

SRF Phase II

8.15.18

