


Gidw.

PROJECT Phase II SHEET _____ OF _____

SUBJECT _____ DATE 2-15-18

JOB NO. 4447

BY Atlas

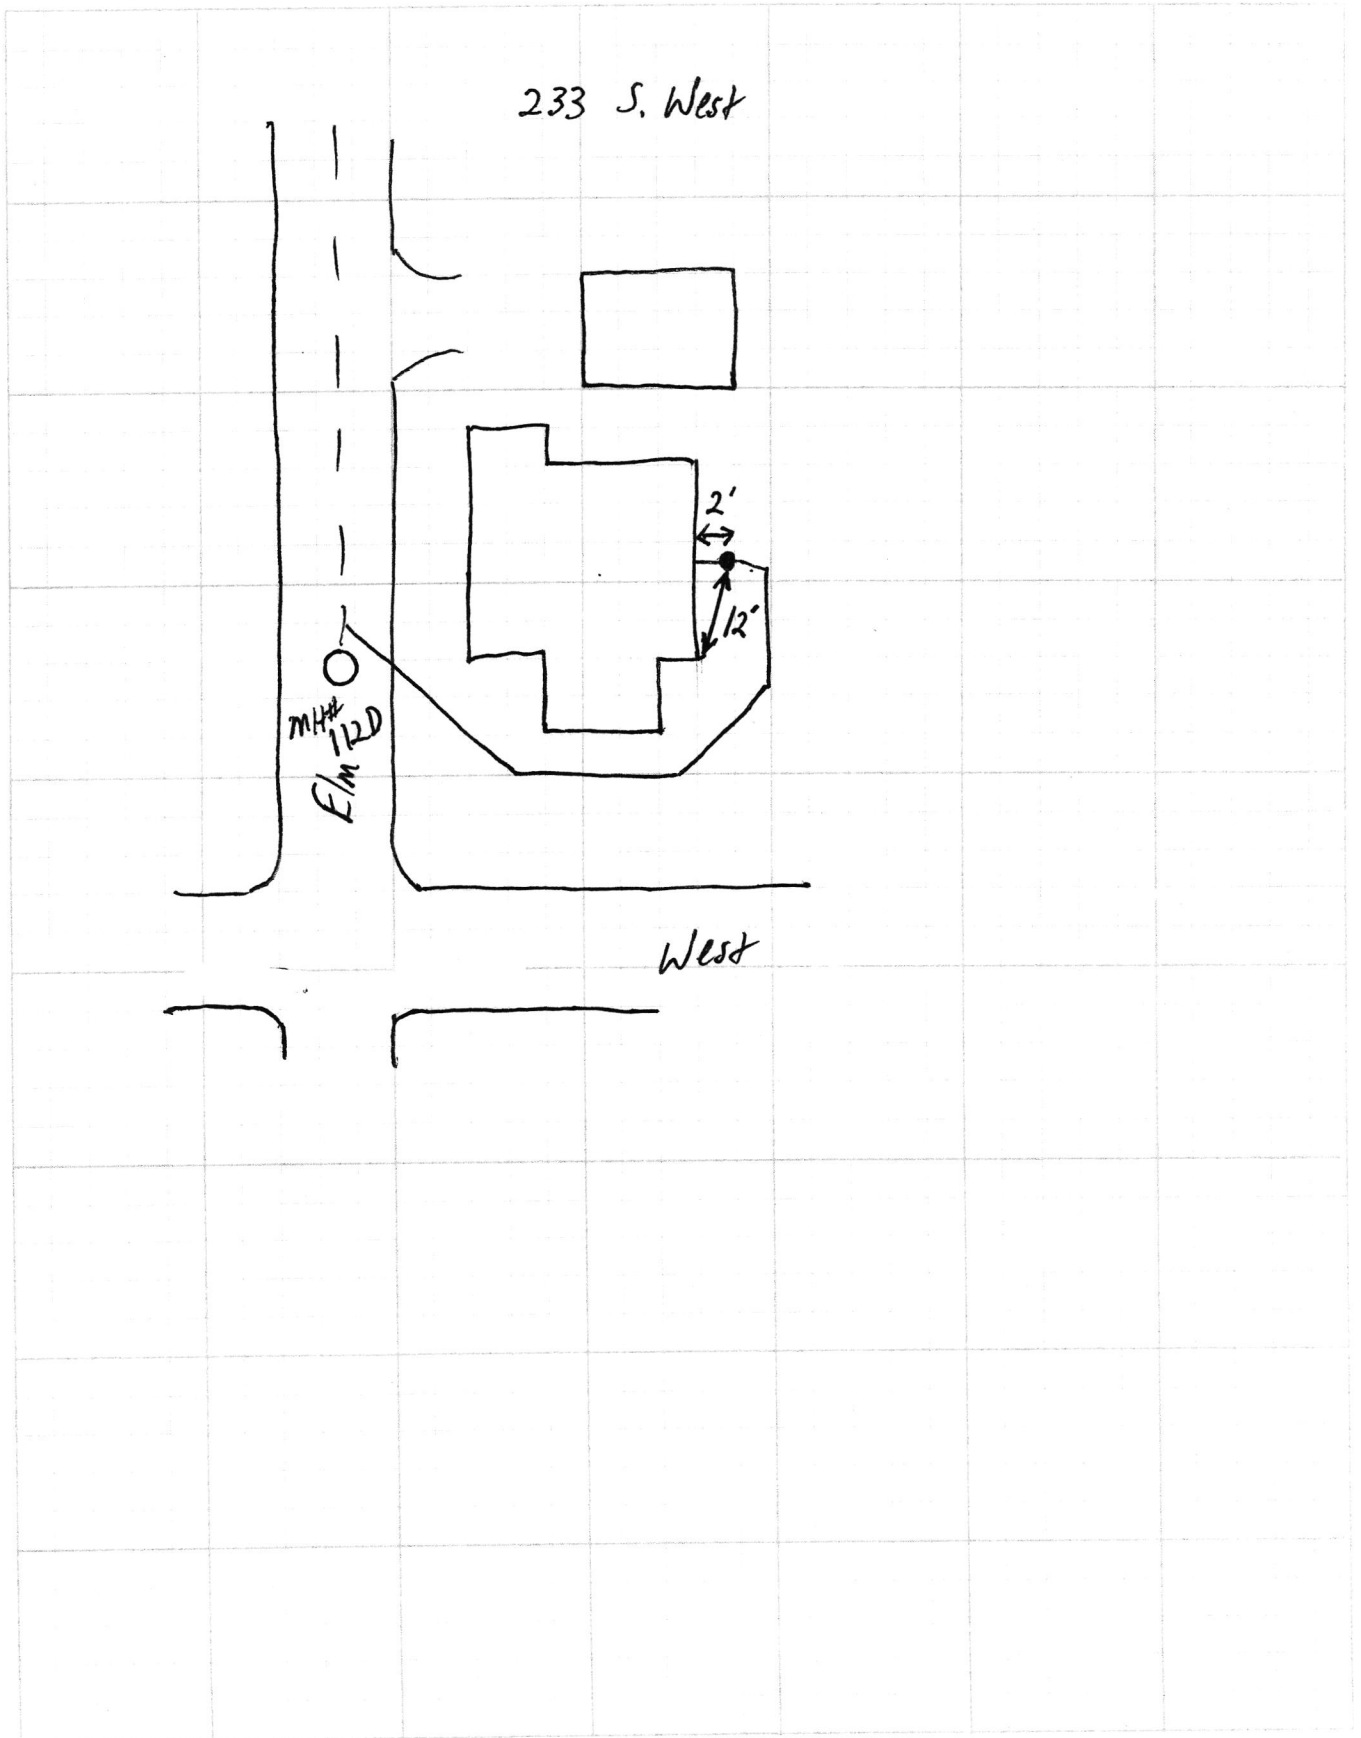

233 S West

SRF Phase II

