

Gidw.


PROJECT Phase II SHEET _____ OF _____

SUBJECT _____ DATE 1-30-18

JOB NO. 4447

BY Atlas

233 W. Tile

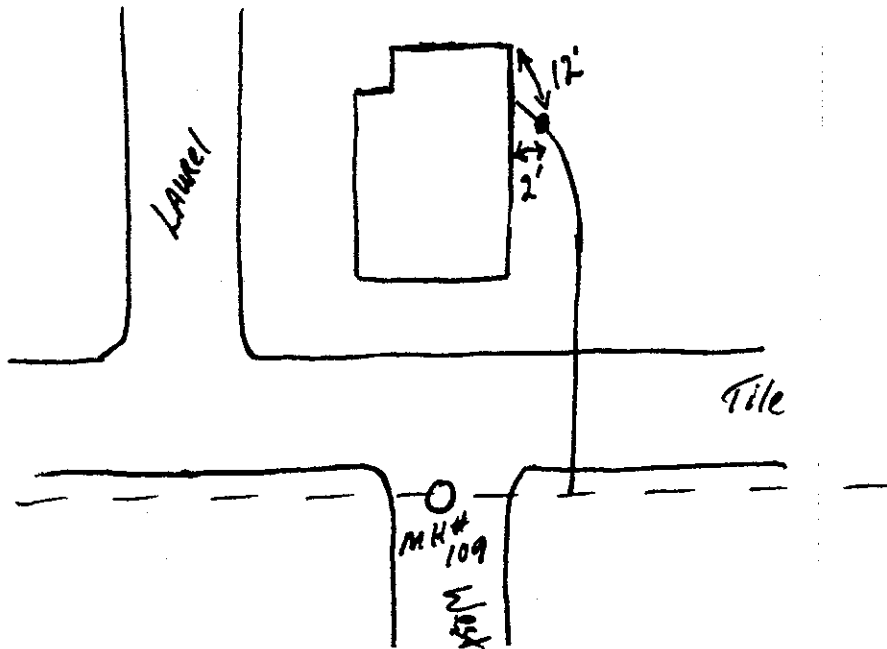

233 W Tile

SRP Phase II

1.30.18

