


Gidw.

PROJECT Phase II SHEET _____ OF _____
SUBJECT _____ DATE 4-9-18
JOB NO 4447
BY AT/AS

234 S. Jefferson

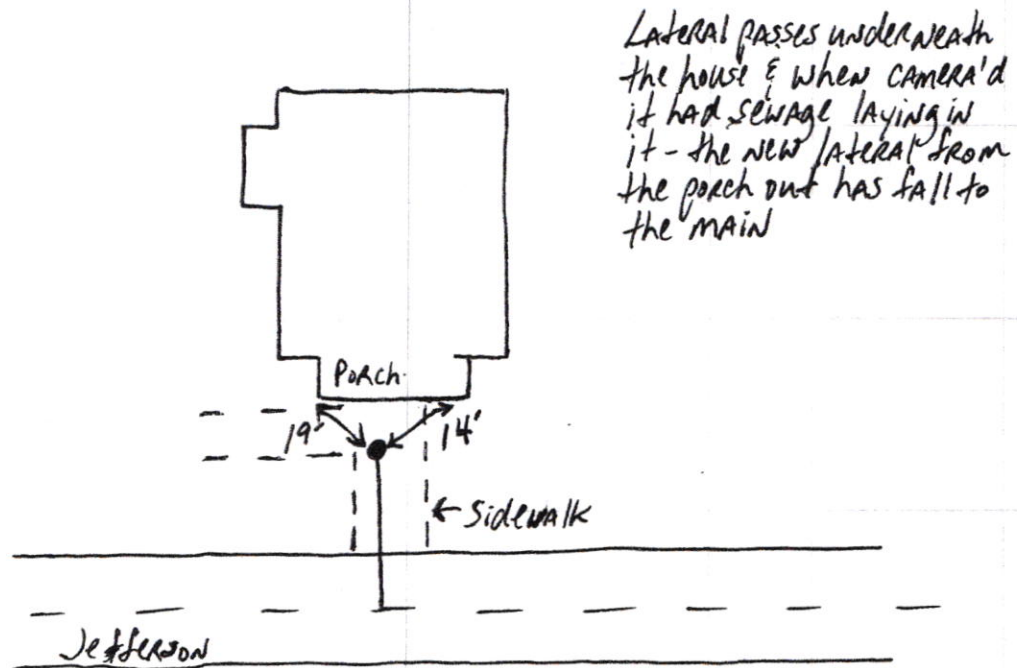

234 S Jefferson

SAP
Phase II

4.11.18

