


GRW

PROJECT Phase II SHEET _____ OF _____
SUBJECT _____ DATE 2-9-18
JOB NO. 4447
BY Atlas

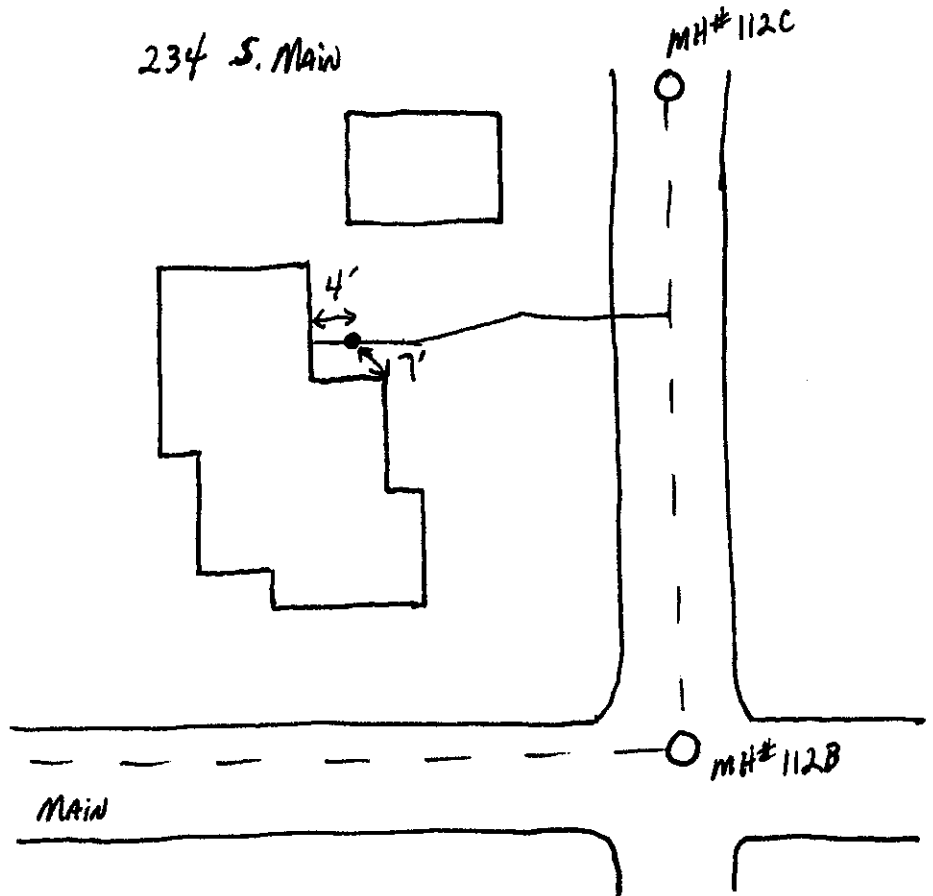

234 S Main

SRF Phase II

