

12/18/17

PROJECT Phase II

SUBJECT _____


SHEET _____ OF _____

DATE 12-18-17

JOB NO. 4447

BY Atlas

234 S. Pendleton

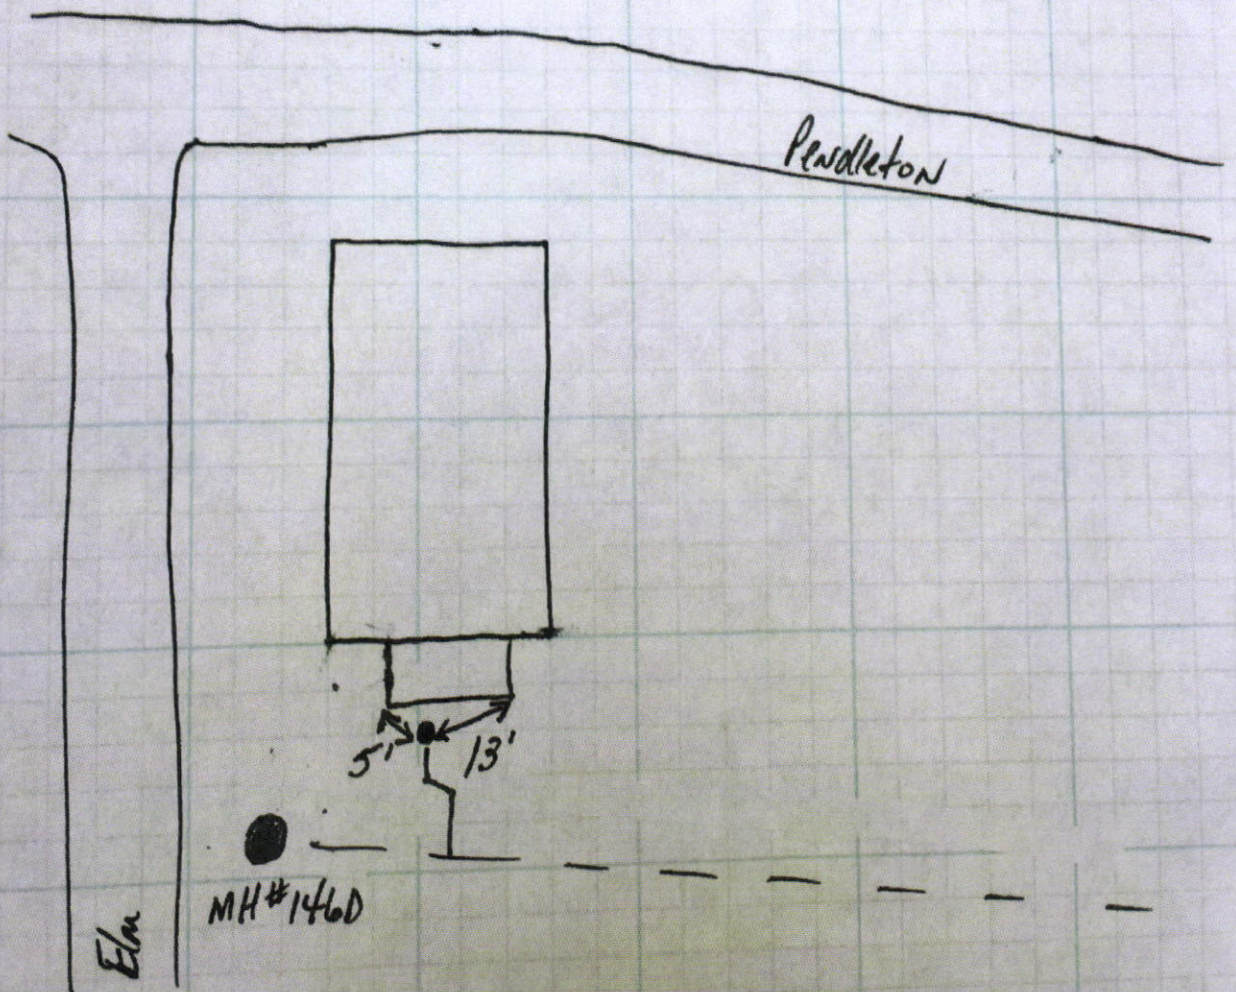

234 S Pendleton Ave

SHP Phase II

12-27-17



