

Gidw.

PROJECT PHASE II SHEET _____ OF _____

SUBJECT _____ DATE 7-2-18


JOB NO. 4447

BY ATLAS

235 PEARL ST.



PEARL ST.

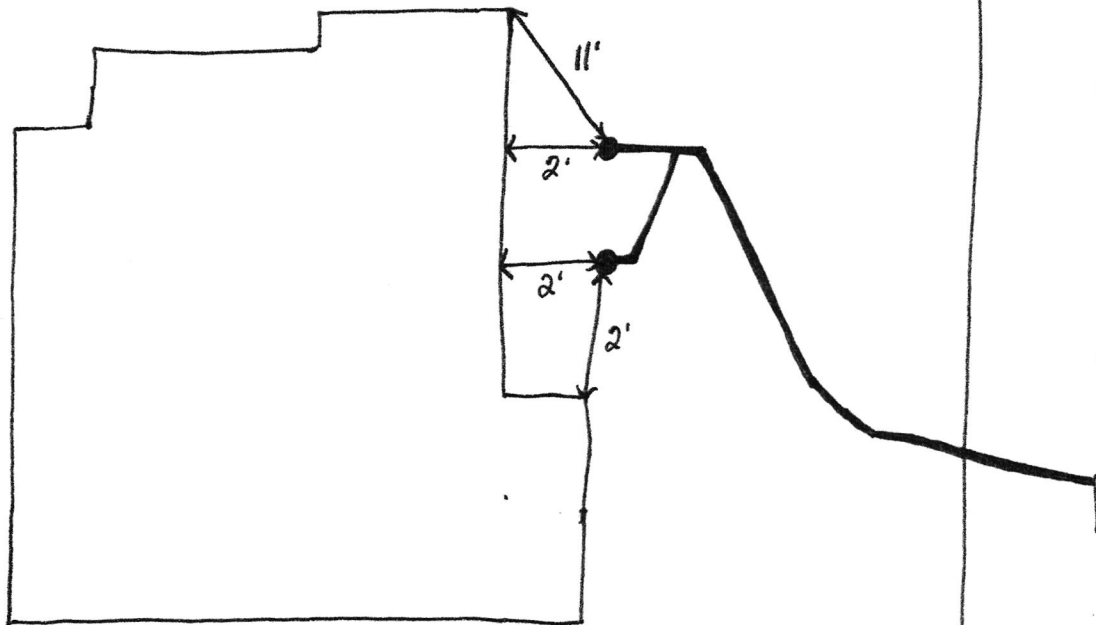

ALLEY

835 Pearl

Soft Phase II

7.10.18

