


Gidw.

PROJECT Phase II SHEET _____ OF _____

SUBJECT _____ DATE 3-9-18

JOB NO. 4447

BY Atlas

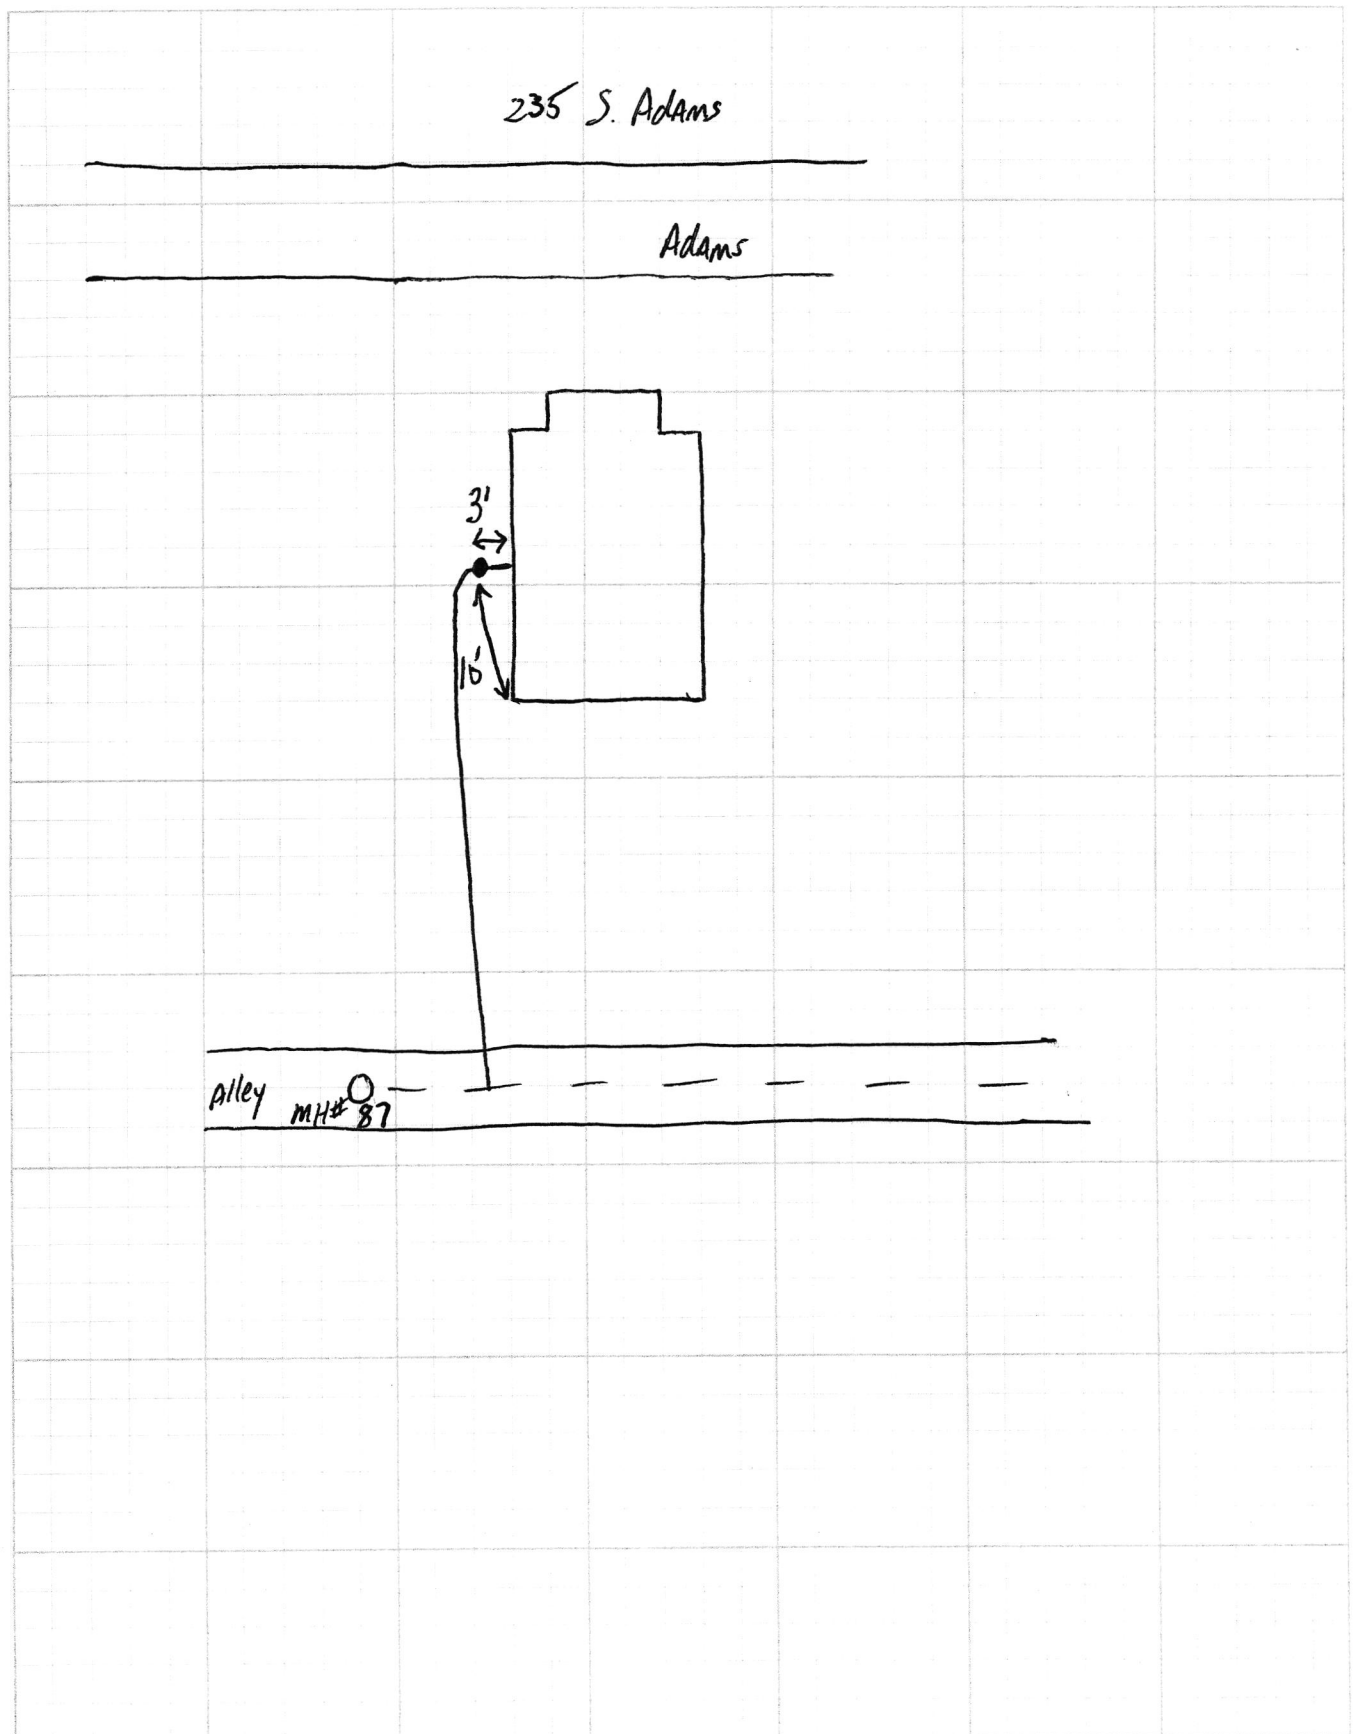

235 S Adams

SPP Phase II

