

GRW.


PROJECT Phase II SHEET _____ OF _____

SUBJECT _____ DATE 7-18-18

JOB NO. 4447

BY Atlas

235 S Broadway

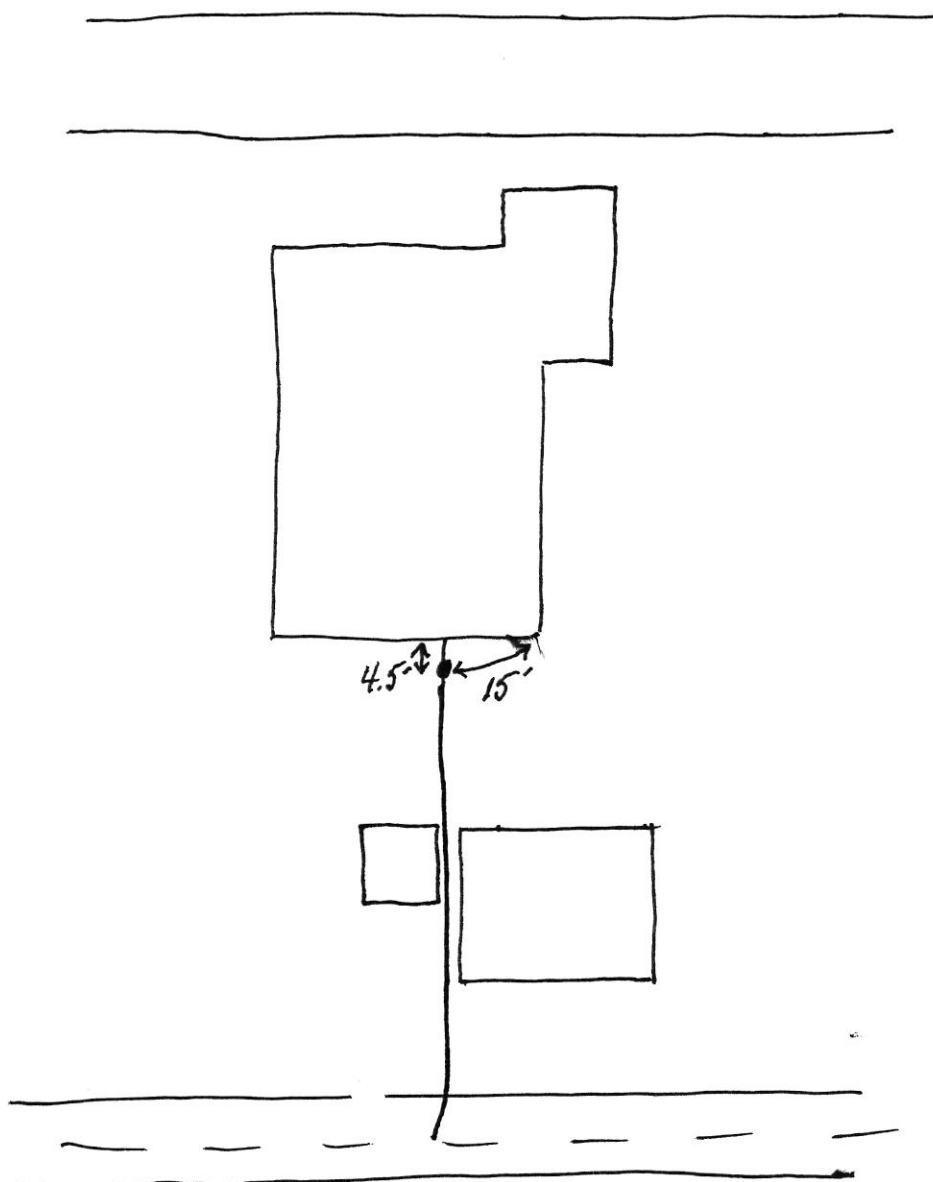

235 S Broadway

SHP Phase II

7.30.18

