


Gidw.

PROJECT Phase II SHEET _____ OF _____
SUBJECT _____ DATE 7-17-18
JOB NO. 4447
BY AHas

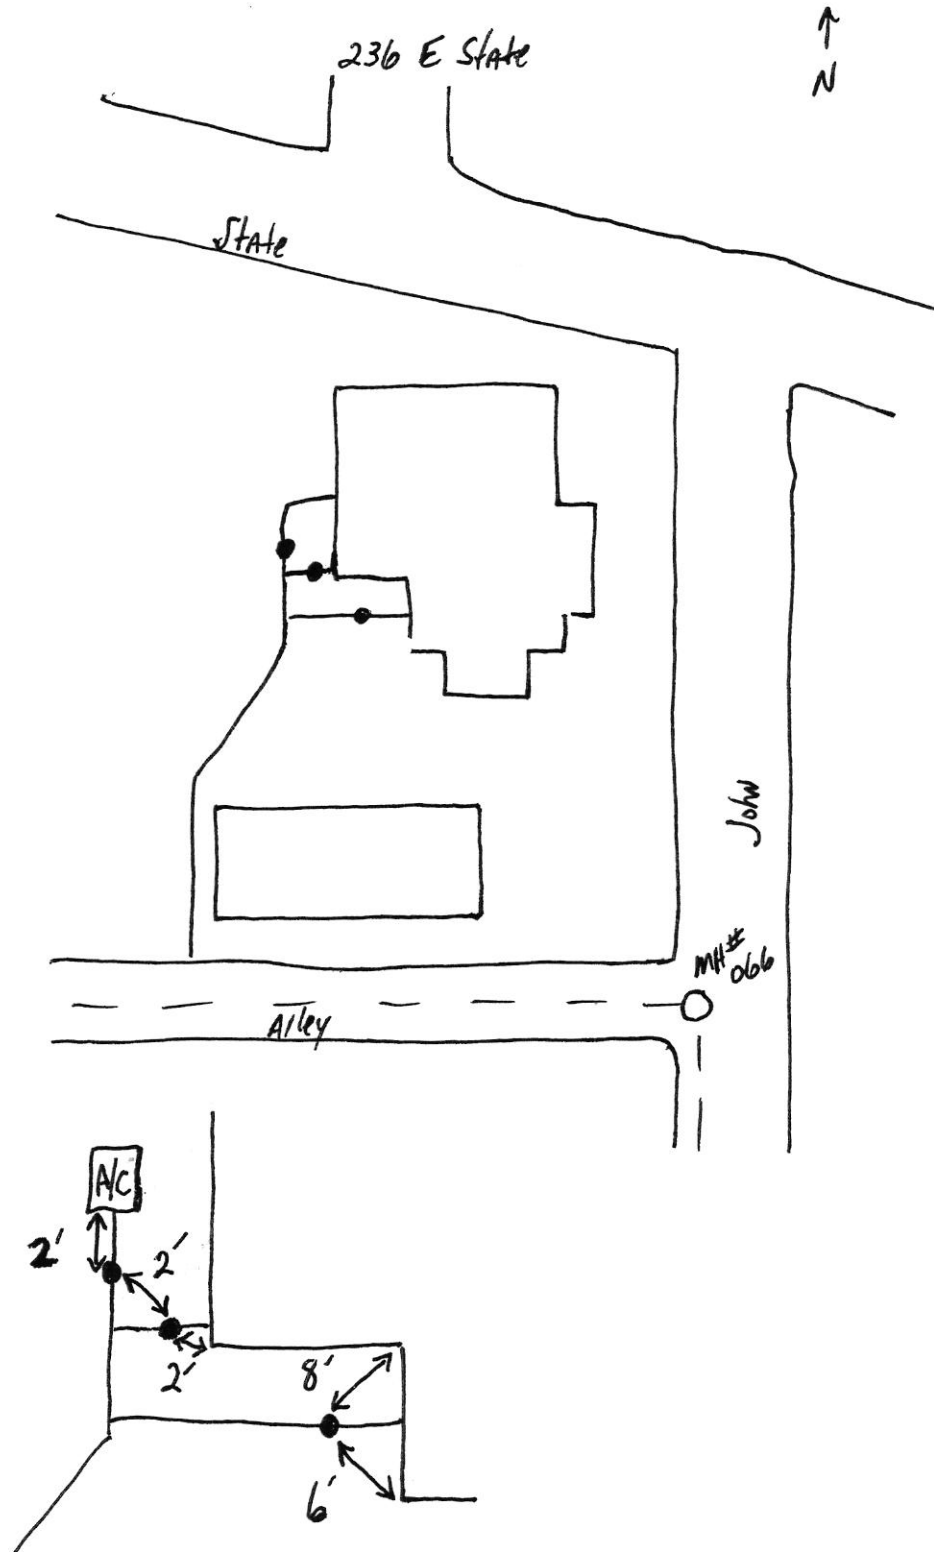

6

SRF Phase II

7.30.18



use to store

SRT phase II

7.30.18

