

Gidw.

PROJECT

Phase

SHEET

OF

SUBJECT

DATE

7-11-18

JOB NO.

4447


BY

Atlas

236 S. West

← N

West

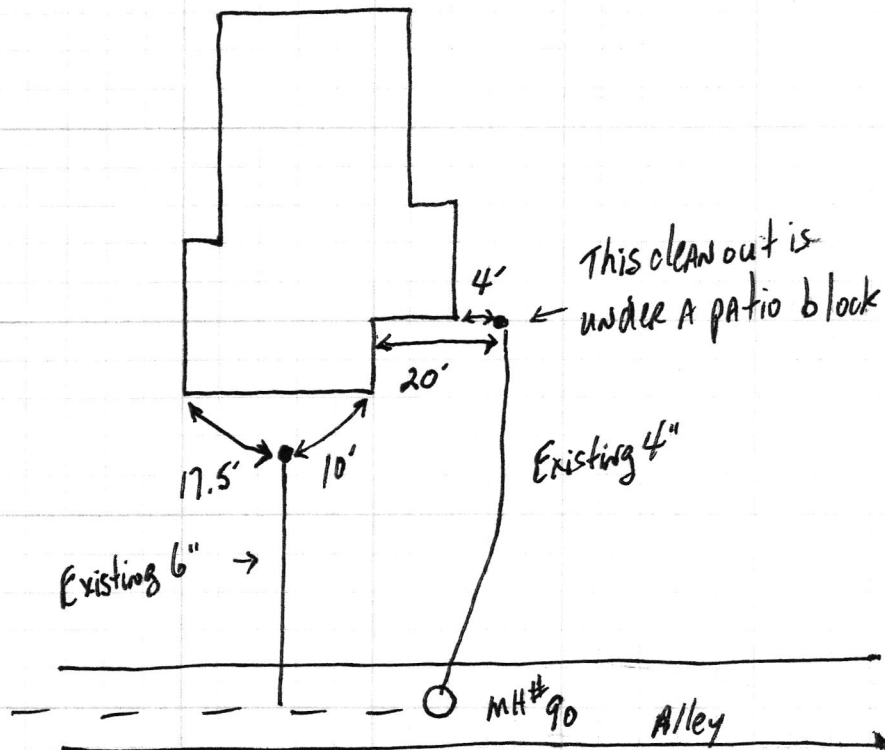



236 West

Sht Phase II

7-18-18



7-18-18

Spr Phase II

was not