

Gidw.

PROJECT

Phase II

SHEET

OF

SUBJECT

DATE

7-9-18

JOB NO.


4447


BY

Atlas

237 E. High

N →

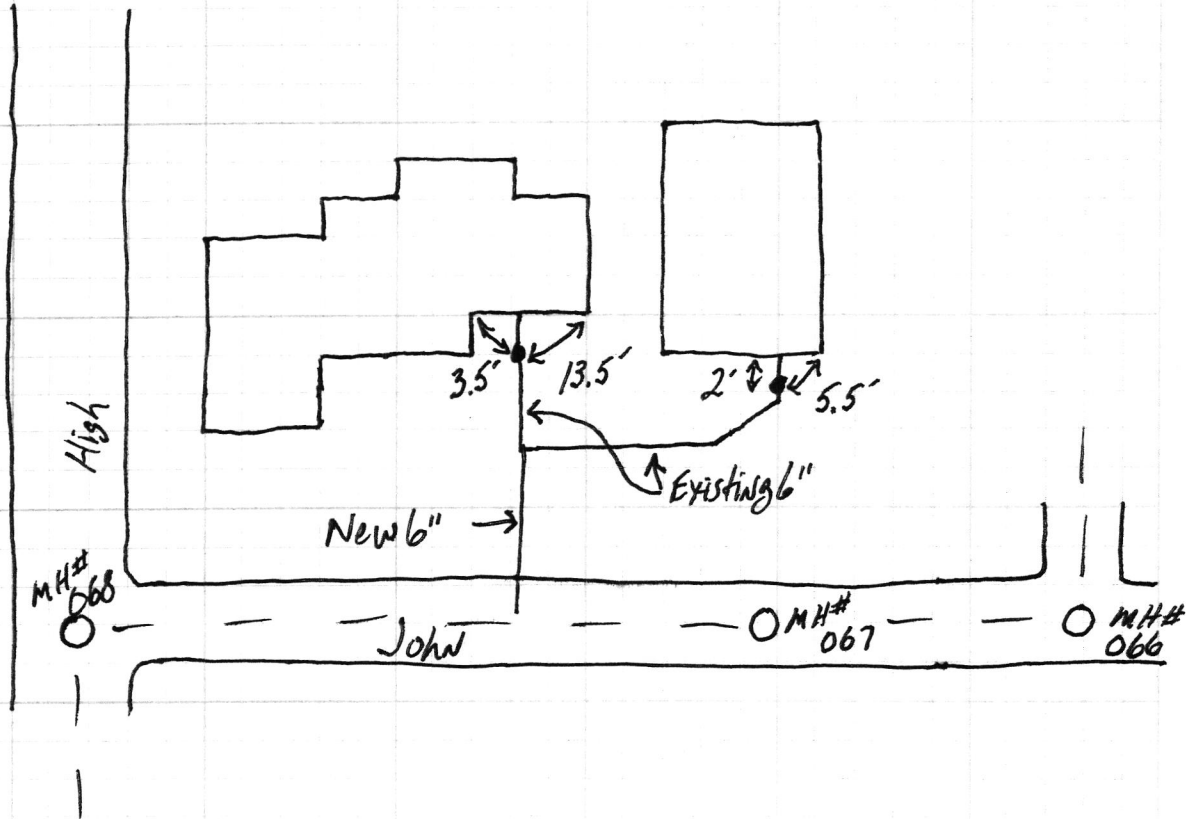


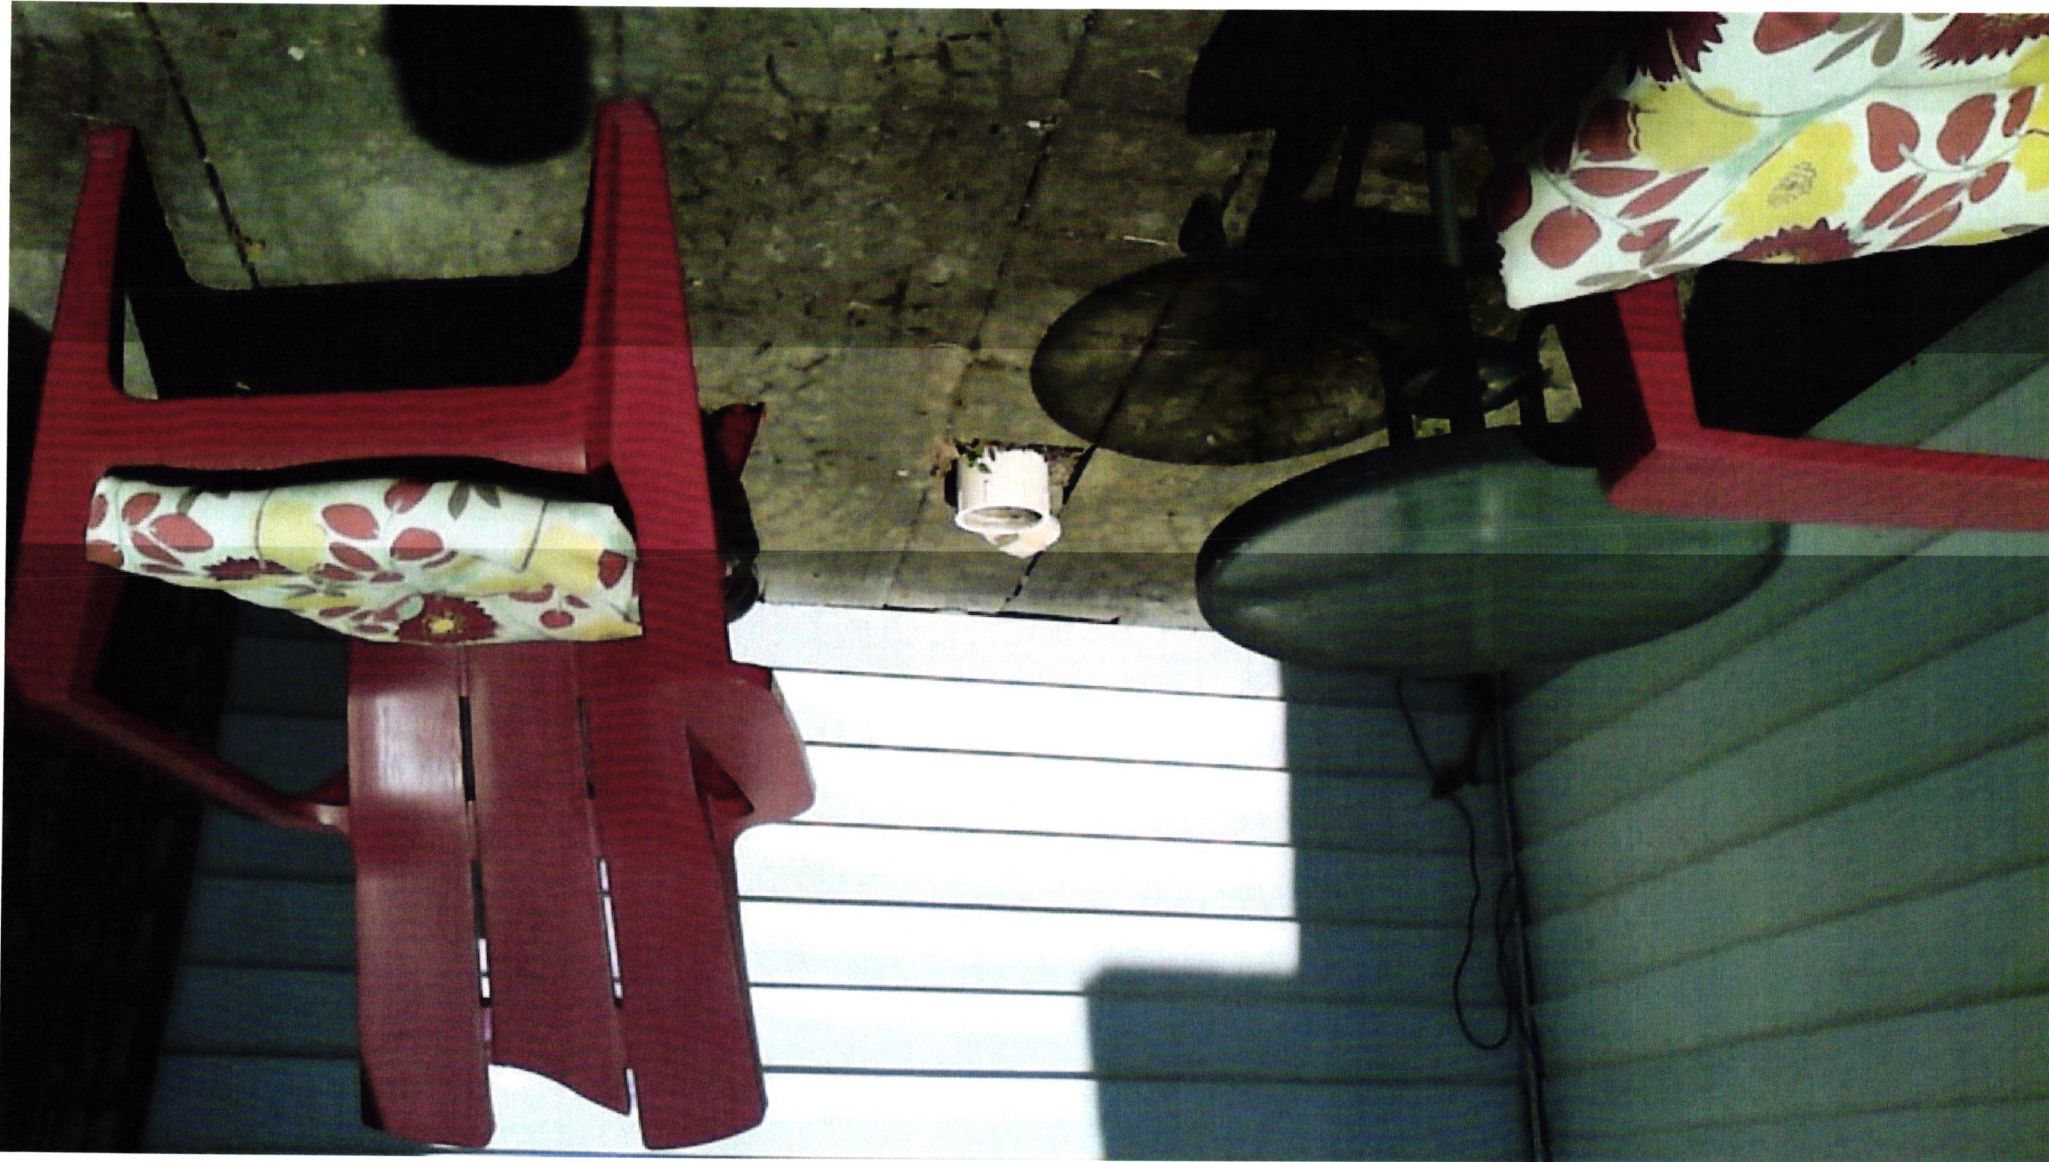

2000-01-18

SHF Phase II

7.11.18

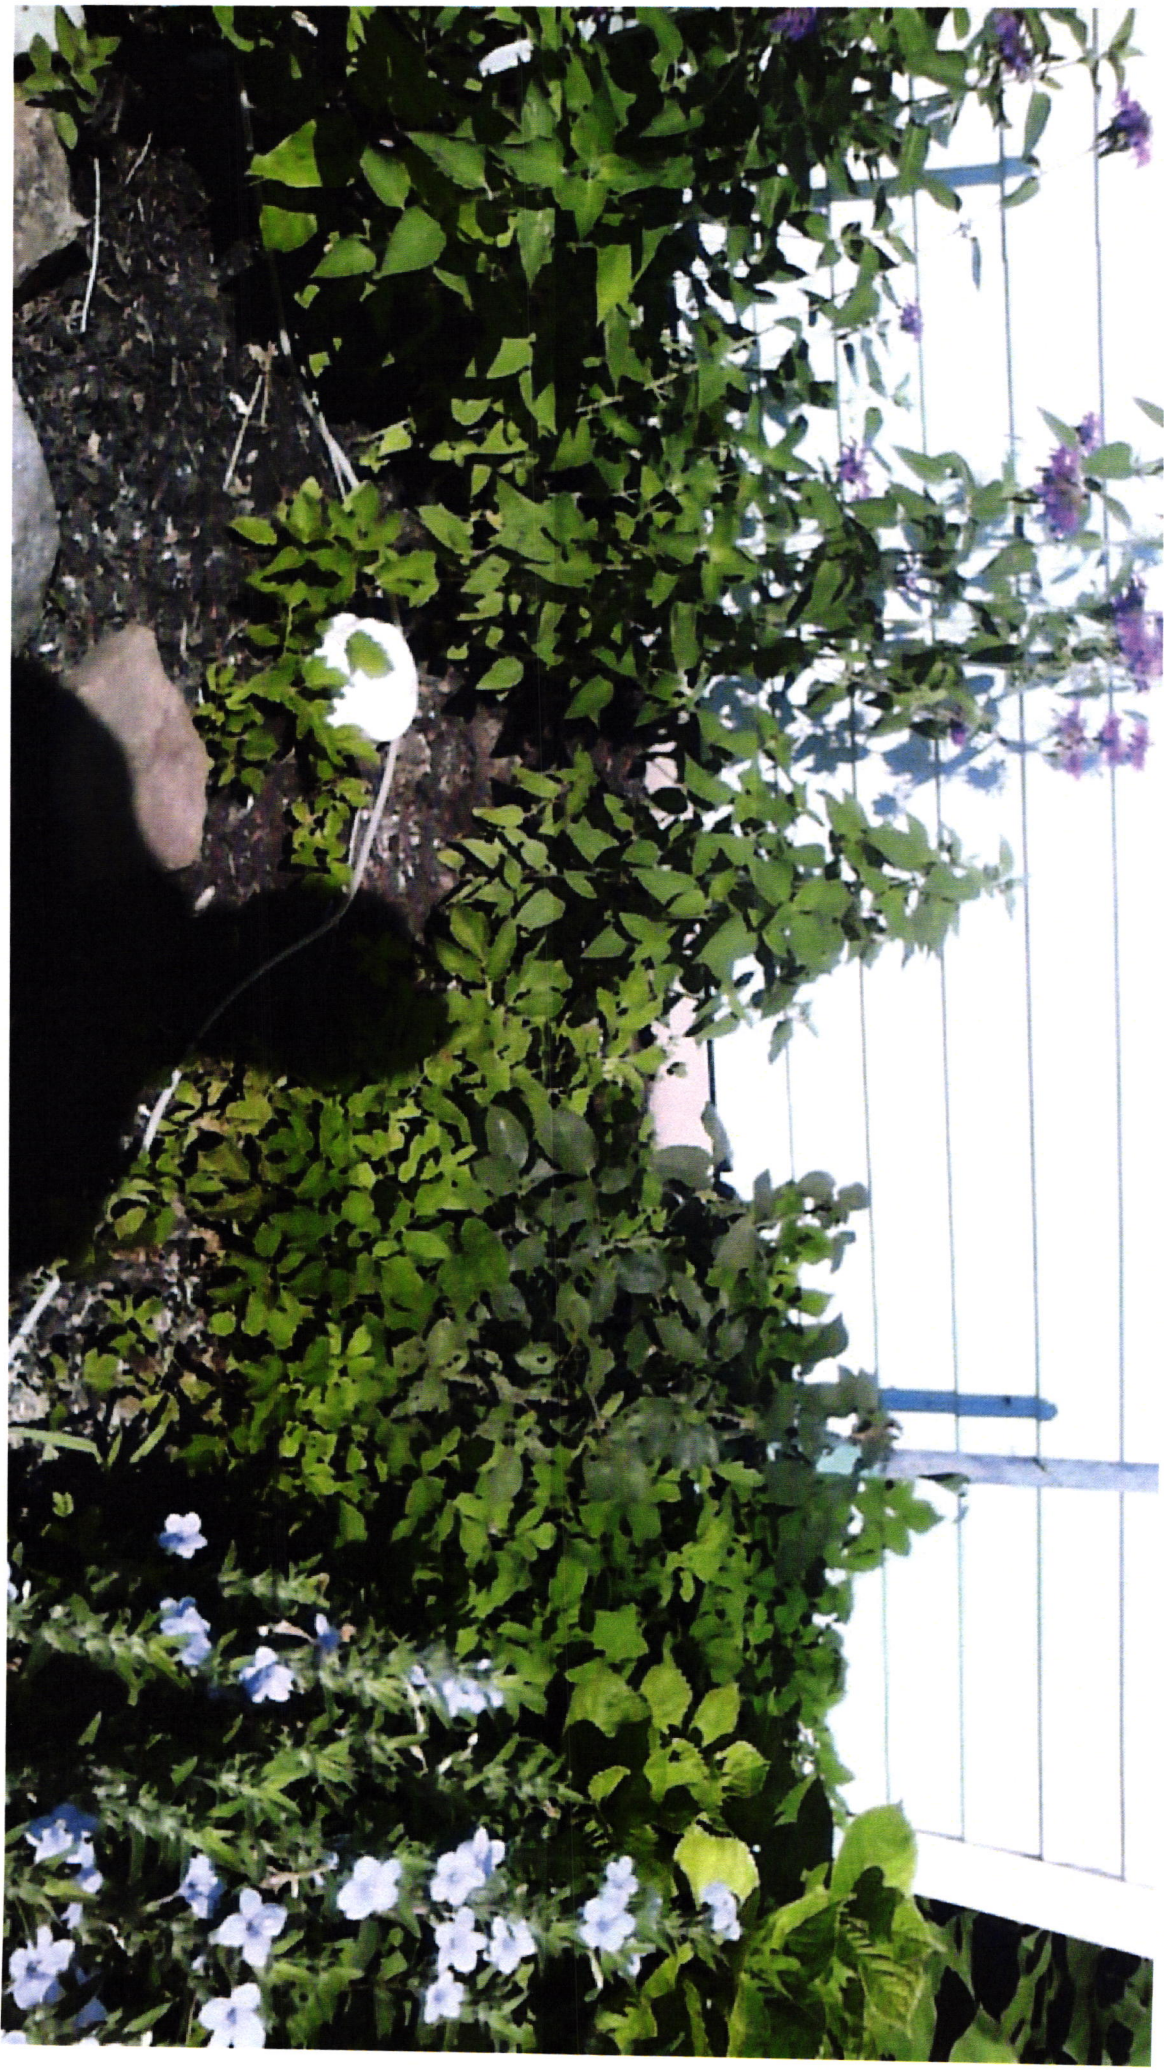

2012 mgn
Garage

Self Phase II

7.11.18