

Gidw.

PROJECT PHASE II

SHEET _____ OF _____

SUBJECT _____


DATE 6-29-18

JOB NO. 4442

BY ATLAS



238 S. EAST ST.

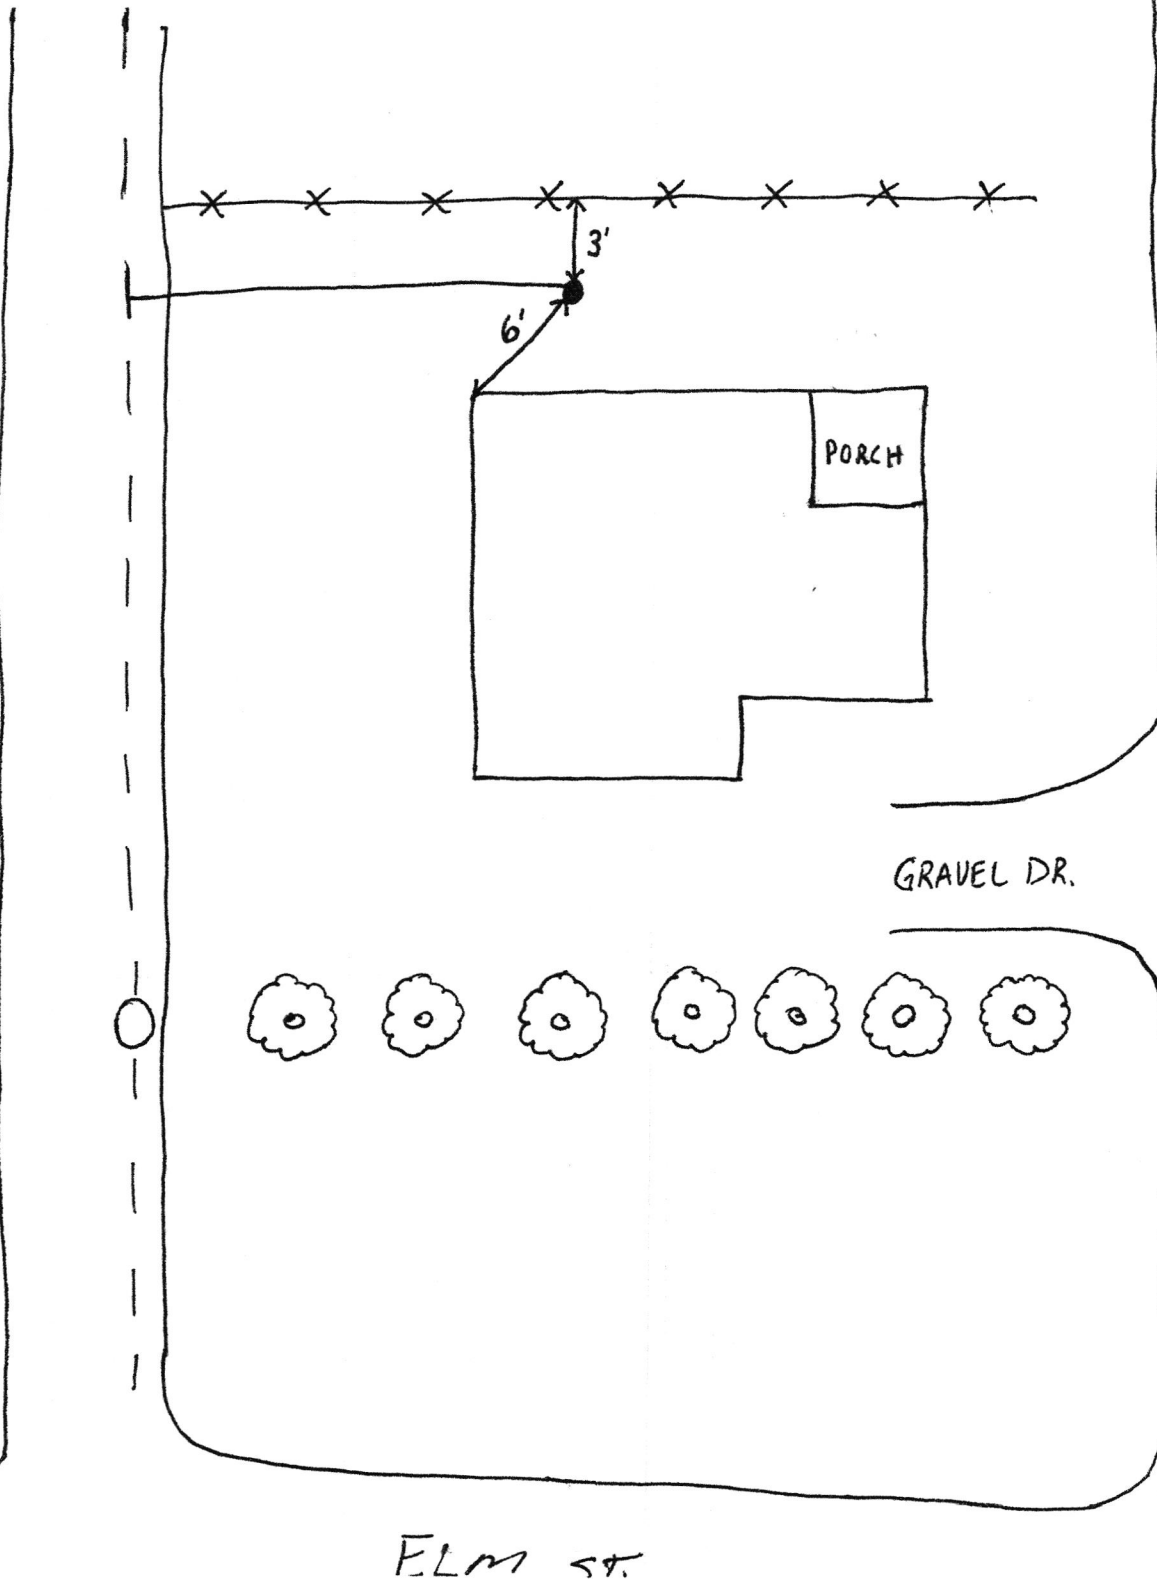

S. EAST ST.

GRAVEL DR.

ELM ST.

238 East

SRT Phase II

7.6.18

