

Gidw.


PROJECT Phase II SHEET _____ OF _____

SUBJECT _____ DATE 2-6-18

JOB NO. 4447

BY Atlas

238 S. Main

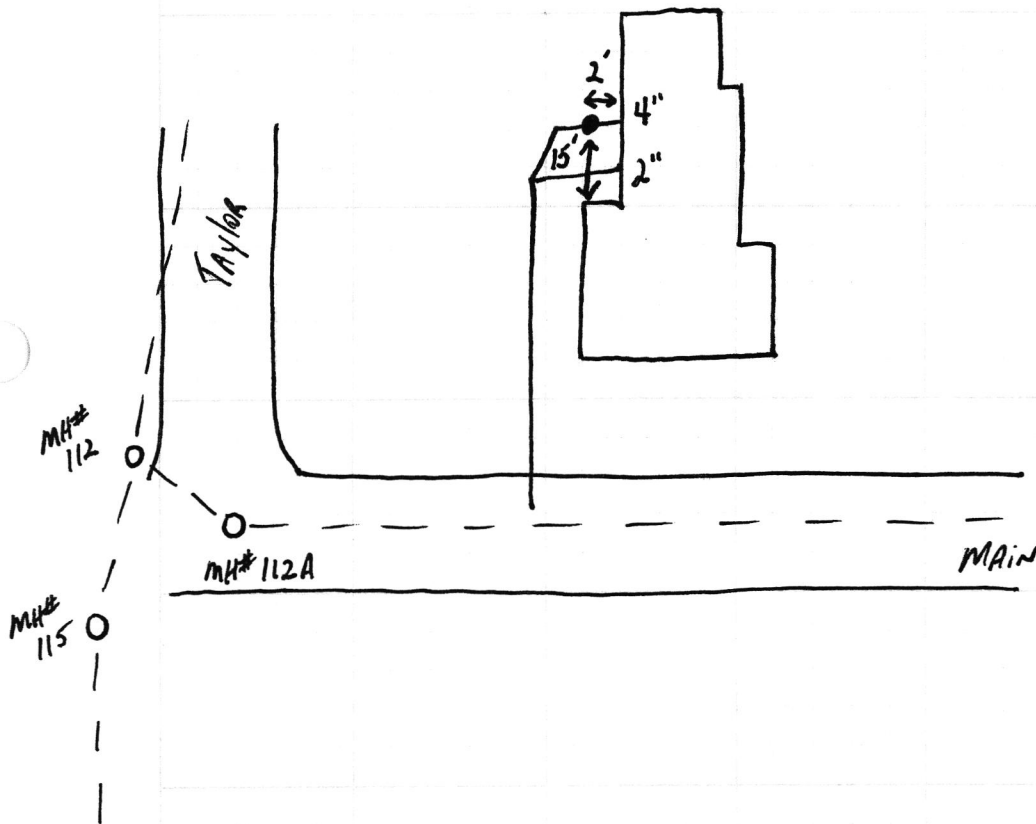

238 S main

SRF Phase II

