

Gidw.

PROJECT

PHASE II

SHEET

OF

SUBJECT

DATE

7-2-18

JOB NO.

4447


BY

ATLAS

239 PEARL ST.

↑  
N

PEARL ST.

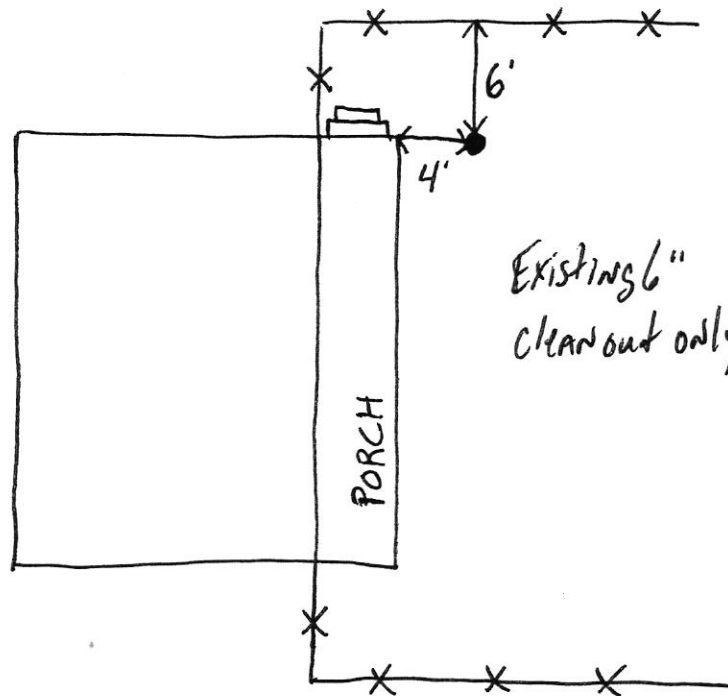

ALLEY

239 Pearl

SHP Phase II

7.6.18

