

Gidw.

PROJECT Phase II


SHEET _____ OF _____

SUBJECT _____

DATE 3-7-18

JOB NO. 4467

BY Atlas

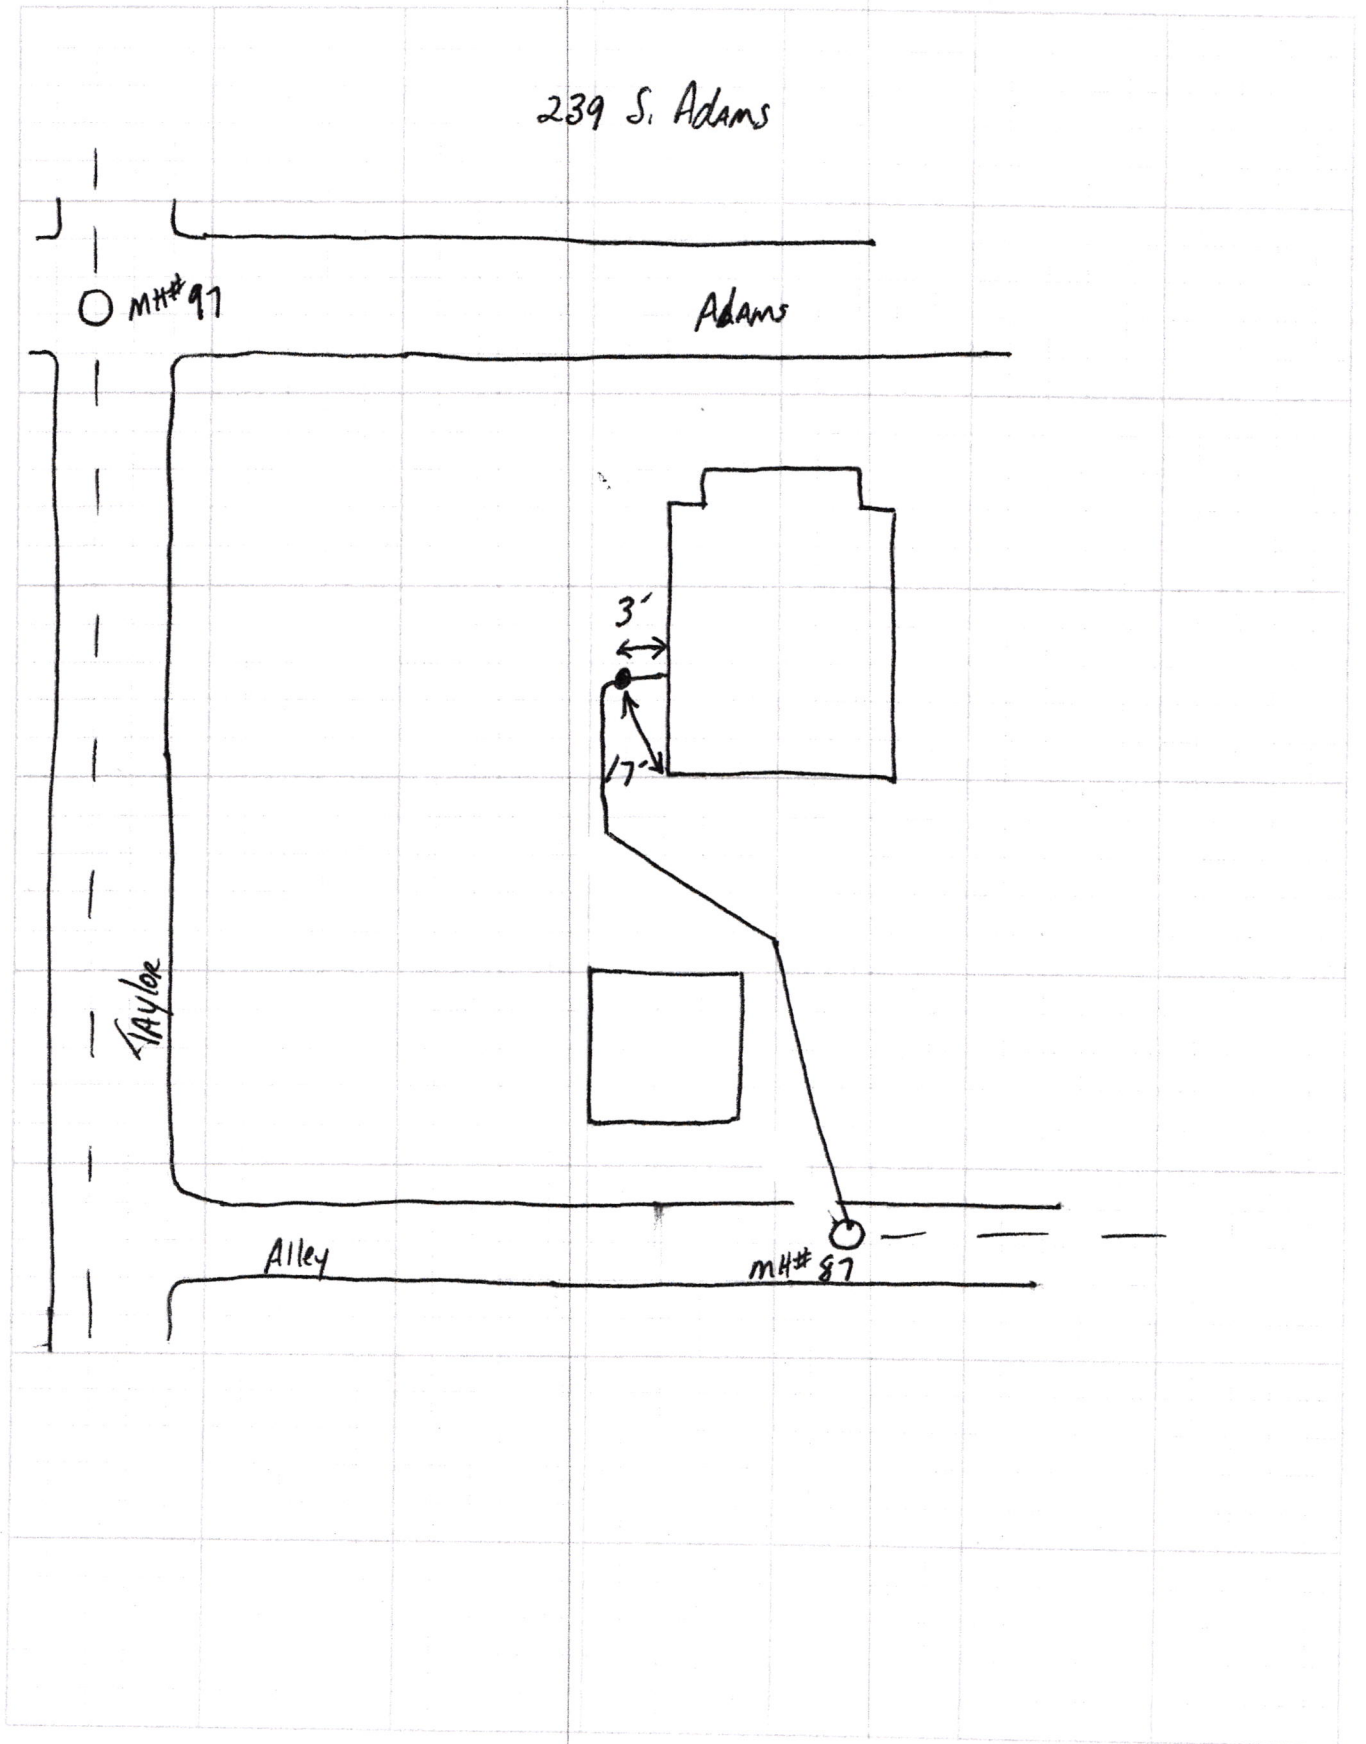

SRP Phase II

239 S Adams

